

Name James IrwinService No. 74 3179Address 60 Taft Avenue# 2861Lexington, Mass.Location 60 Taft Avenue

Kind of Pipe

Size

Size of Main

~~Repair~~ New ServiceCom 12-16-46

Location

Date

Material

Amount

Total

Date

Amount

Aug. 30, '46

Labor

9 51

9 51

Aug. 12, '46

*Deposited*

40 00

10% Overhead

95

32' -  $\frac{3}{4}$ " Copper Tubing @.23

7 36

Non-Charge

1 -  $\frac{3}{4}$ " C x  $\frac{1}{2}$ " I.W.H. S & W

2 82

Aug. 30, '46 Labor

18 06

Patching 19' - 3'

19 00

22' -  $\frac{3}{4}$ " Copper Tubing @.23

5 06

Trucking 1 hr. @.75

75

1 -  $\frac{3}{4}$ " C Corp-cock

2 70

40 39

1 -  $\frac{3}{4}$ " C x  $\frac{3}{4}$ " C Curb-cock

3 30

1 - Box &amp; Rod

3 35

*No additional bill sent*1 -  $\frac{1}{2}$ " Straight Tail Piece

50

1 -  $\frac{1}{2}$ " Offset Tail Piece

50

Compressor 2 hrs. @1.75

3 50

Trucking 1 hr. @.75

75

Labor

37 72

DATE \_\_\_\_\_

# TOWN OF LEXINGTON—BOARD OF PUBLIC WORKS

## WATER DIVISION

The undersigned applies for a supply of water at No. \_\_\_\_\_ St. and hereby agrees to comply with the rules and regulations as now, or at any future time, established by the Board of Selectmen.


Am't. of Estimate \$ \_\_\_\_\_

Owner \_\_\_\_\_

Am't. Paid \$ \_\_\_\_\_

Address \_\_\_\_\_

Builder \_\_\_\_\_

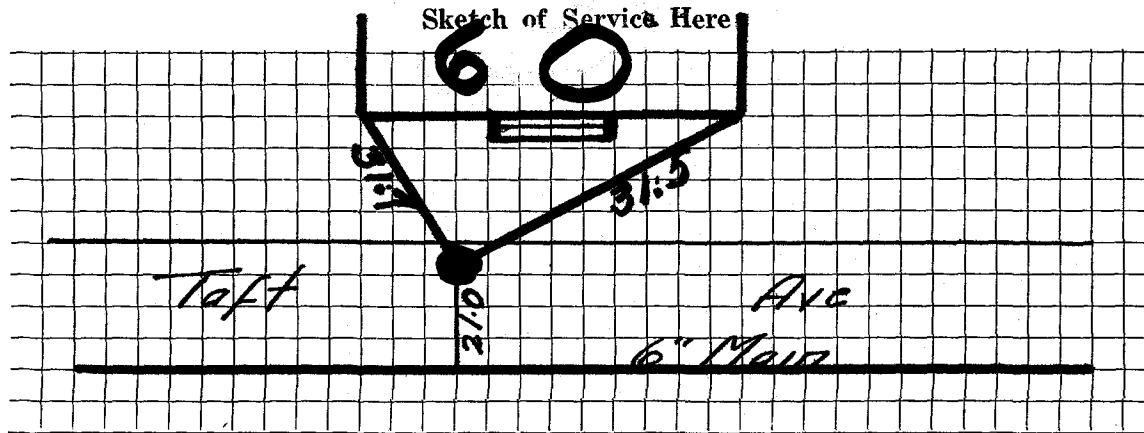

Connection made in \_\_\_\_\_ Street.

Work completed \_\_\_\_\_ 19

Remarks: