

WATER SERVICE RECORD

Name Harold Asp

Service No. 306

Address 61 Taft Avenue

Location

Repair ~~Repair~~ New Service

*Com. 11-9-53*


Date	Material	Amount	Total	Date	Amount
10/7/53	Labor	1 75		7-22-53 11-9-53	Deposited Refunded
	10% Overhead	18	1 93		25 00 5 26
	36' - 3/4" Copper tubing @ .3629	13 06			NON CHARGE
	1 - 3/4" C x 1/2" I.W.H. stop & waste	4 00		10/7/53	Labor
	1 hr. trucking		75		2 92
			19 74	12' - 3/4" Copper tubing @ .3629	4 35
				1 - 3/4" C. corp-cock	4 33
				1 - 3/4" C x 3/4" C. curb-cock	4 67
				1 box and rod	3 90
				1-1/2" offset tail piece	50
				1-1/2" straight tail piece	50
				1 hr. trucking	75
					21 92
				4/5/58	
				2 3/4" 3 part unions	

DATE \_\_\_\_\_

TOWN OF LEXINGTON — BOARD OF PUBLIC WORKS

WATER DIVISION

Sketch of Service Here

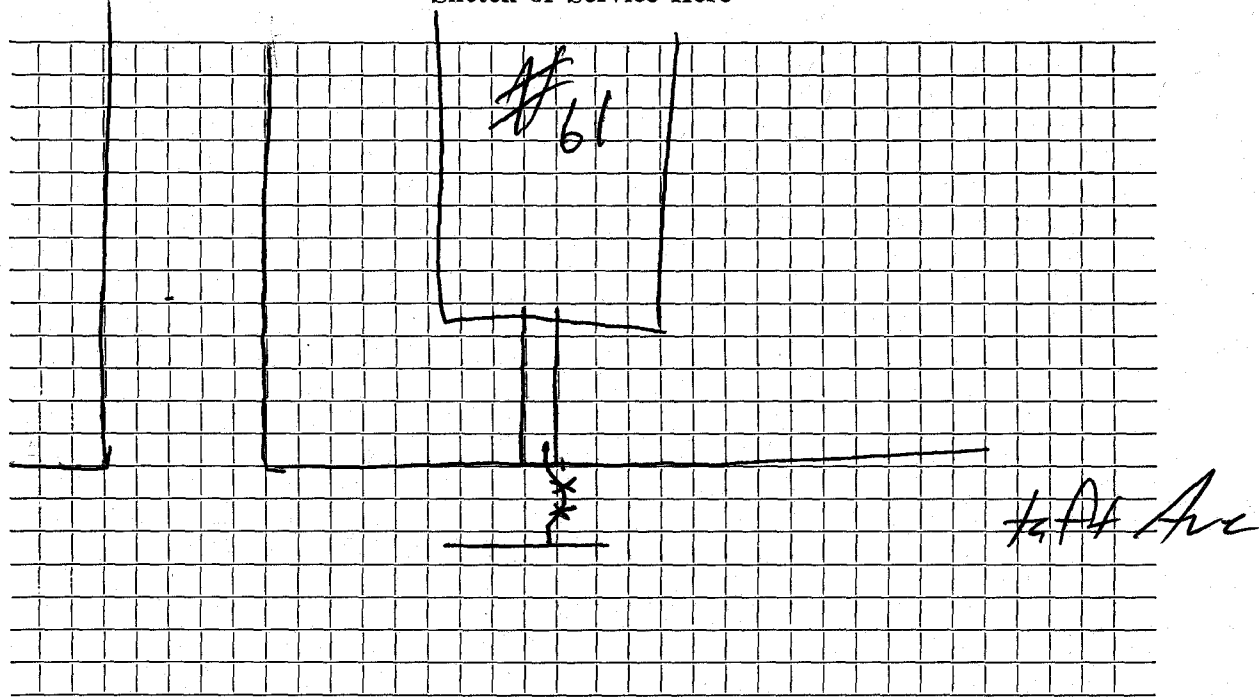

Connection made in ..... Street. Work completed .....

Remarks: ... repair made 4/9/58 ... 3 ft from curb in street 1' of  $\frac{3}{4}$  copper 2 unions  
... gas main same depth as water .....