

WATER SERVICE RECORD

Name Scanlan & Kavanagh

Service No. 2

Address 62 Taft Avenue

Location Valeri Const. Permit #A174

~~Repair - Break~~ - New Service W.O. #1614

MAY 2 1966


Date	Material	Amount	Total	Date	Amount
1-20-66	Labor	52.00		1-13-66	50 00
3-31-66	"	38.89	90.89	5-2-66	5 49
	10% O.H.	9.09	99.98	5-11-66	143 90
26'	3/4" Copper tubing @70		18.20		199 32
1	3/4" Curb Cock		8.76		
1	3/4" Corp Cock		7.41		
1	Box & Rod		5.50		
33	Sticks Dynamite @.27		8.91		
12	Blasting Caps @.28		3.36		
2	hrs. Town Shovel @6.50		6.50		
3	hrs. Compressor @5.00		15.00		
1	hr. Nelson Loader @4.00		4.00		
1	hr. Trucking @3.00		3.00		
1	hr. Roller @3.00		3.00		
1	hr. Trailer @2.00		2.00		
2½	ton hot top @5.50		13.75		
			199.37		
2-15-66	36' 3/4" Copper tubing				Bill sent 143.90

DATE _____

TOWN OF LEXINGTON — BOARD OF PUBLIC WORKS

WATER DIVISION

Sketch of Service Here

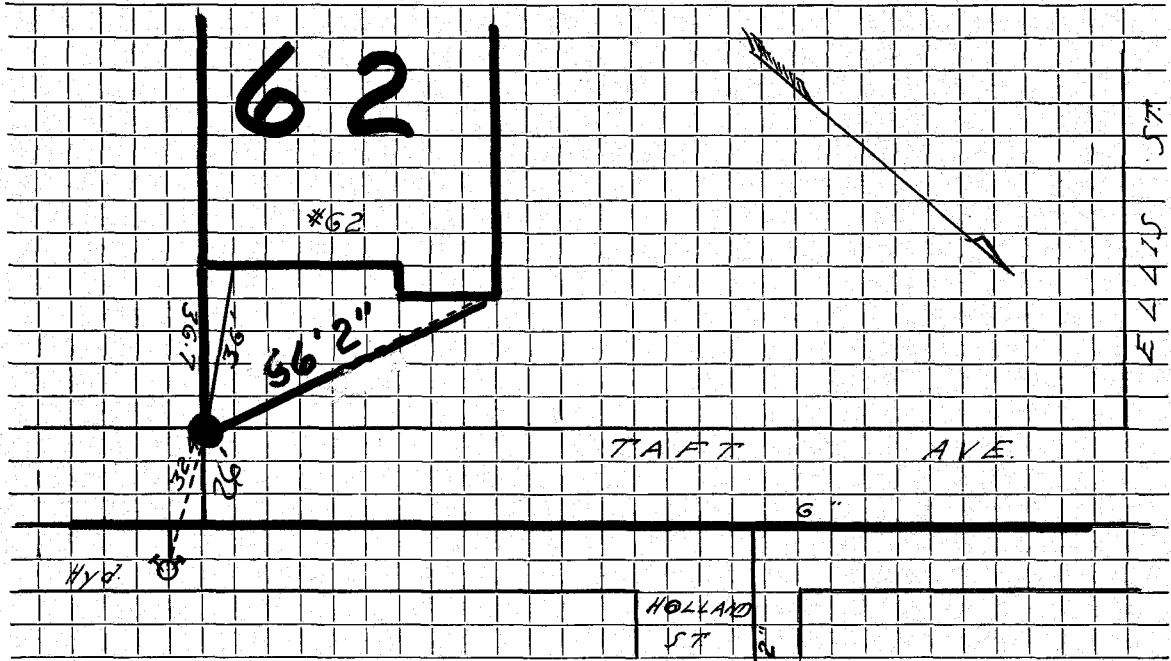

Connection made in Street. Work completed

Remarks:
.....
.....