

Name George H. Doughty

Service No. 2654

Address #64 Taft Avenue

Location

Kind of Pipe

Size

Size of Main

~~Rank - Renewal - Max State~~

Location

8-11-18-30  
19.50

Hadley Press, Inc. Lexington

10/18/

CHARGE

Date	Material	Amount	Total	Date	Amount
26	1" C.L. Pipe @.27	7 02		A.R. 1-23-31	
	1 1" L.L. Coup.	30		Jan. 27 1931 - Cash	19 50
	2 1" L.L. Ells @.35	70			
	2 1" Br. Sp. Nip. @.30	60			
	1 S & W	3 00			
	Trucking	75	12 37	Checked Outside 3/4 Copper	
	7 Hrs. Labor @.55	3 85			
	3 " " @.60	1 80	5 65		
	15% Overhead		85		
	<u>COST</u>		18 87		
	Labor				
	<u>CHARGE</u> 26' @ .75	\$19 50	\$19 50		

DATE \_\_\_\_\_

# TOWN OF LEXINGTON — BOARD OF PUBLIC WORKS

## WATER DIVISION

The undersigned applies for a supply of water at No. \_\_\_\_\_ St. and hereby agrees to comply with the rules and regulations as now, or at any future time, established by the Board of Selectmen.

Am't. of Estimate \$ \_\_\_\_\_


Owner \_\_\_\_\_

Am't. Paid \$ \_\_\_\_\_

Address \_\_\_\_\_

Builder \_\_\_\_\_

Sketch of Service Here

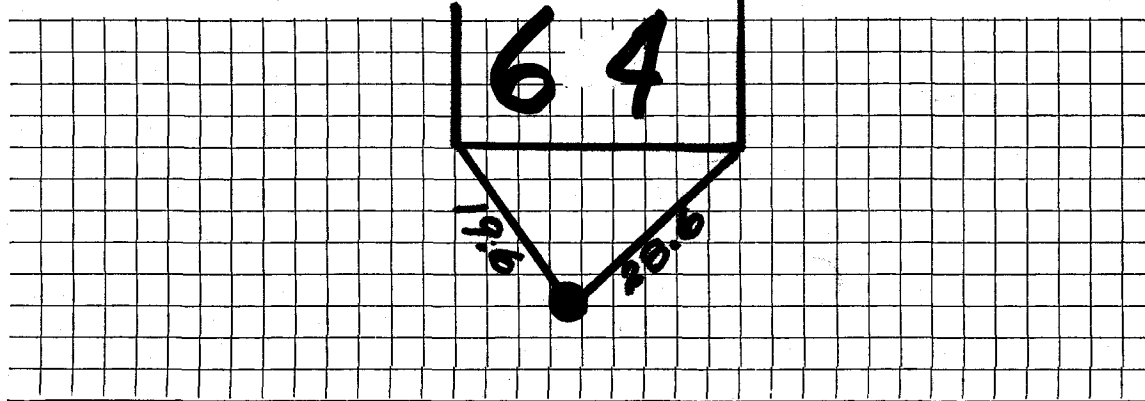

Connection made in \_\_\_\_\_ Street.

Work completed \_\_\_\_\_ 19

Remarks:



DATE \_\_\_\_\_

TOWN OF LEXINGTON — BOARD OF PUBLIC WORKS

**WATER DIVISION**

Sketch of Service Here

A large grid of graph paper, consisting of 20 columns and 20 rows of small squares, intended for sketching service details.

Connection made in ..... Street.                      Work completed .....

Remarks: .....  
.....  
.....