

Name Clifford L. Costello

1366
Service No. 143

Address 65 Taft Avenue

Lexington, Mass.

Location 65 Taft Avenue

Kind of Pipe

Size

Size of Main

~~Repair~~ ~~Renewal~~ — New Service

Location

| Date | Material | Amount | Total | Date | Amount |
|--------------|--------------------------------|--------|-------|--------------------------------|--------|
| Aug. 31, '48 | Labor | 1 15 | 1 15 | Aug 20 '48 | 15 00 |
| | 10% Overhead | | 12 | | |
| | 42' - 3/4" Copper Tubing @.255 | 10 71 | 10 71 | | |
| | 1 - 3/4" C x 1/2" I.W.H. S & W | 3 15 | 3 15 | | |
| | Trucking 1 hr. @.75 | 75 | 75 | | |
| | | | 15 88 | | |
| | | | | Aug. 31, '48 | 1 15 |
| | | | | | |
| | | | | 43' - 3/4" Copper Tubing @.255 | 10 97 |
| | | | | 1 - 3/4" C Corp-cock | 3 00 |
| | | | | 1 - 3/4" C x 3.4" C Curb-cock | 3 68 |
| | | | | 1 - Box & Rod | 3 55 |
| | | | | 1 - 1/2" Offset Tail Piece | 30 |
| | | | | 1 - 1/2" Straight Tail Piece | 30 |
| | | | | Trucking 1 hr. @.75 | 75 |
| | | | | | 23 70 |
| | Labor | | | | |

Hadley Press, Inc., Lexington

TOWN OF LEXINGTON—BOARD OF PUBLIC WORKS

WATER DIVISION

The undersigned applies for a supply of water at No. _____ St. and hereby agrees to comply with the rules and regulations as now, or at any future time, established by the Board of Selectmen.

Am't. of Estimate \$ _____


Owner _____

Am't. Paid \$ _____

Address _____

Builder _____

Sketch of Service Here

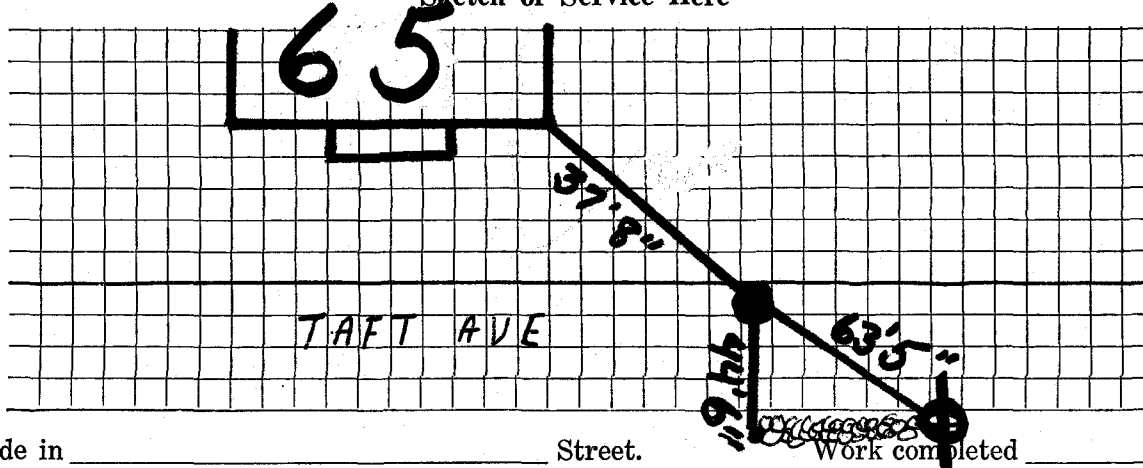

Connection made in _____ Street.

Work completed _____ 19__

Remarks: