

Name Harry E. Johnson

Service No. ²⁰⁵ ~~30~~ 2629

Address 1070 Mass. Ave., Arlington

8 Taft Ave.

718 Taft Ave.

Location Lot #4 Taft Ave.

Kind of Pipe

Size

Size of Main

~~Repairs~~ ~~Renovations~~ ~~New Service~~ Miscel.

Location

Date	Material	Amount	Total	Date	Amount
Sept. '1934	37' 1" C.L. Pipe @.27	\$9 99			
Con. 11-70 to Russell 12-31-34	1-1" L.L. Ell	35		Aug. 25 1934 - Reported	11 70 ✓
	1 Br. Sp. Nip.	25			
	1 S & W	2 75			
	Trucking	75	\$14 09	Checked outside 3/4 Cap	
	<u>CHARGE</u> Estimated cost, 39' @.30-		<u>\$11 70</u>		
	Labor				

Hadley Press, Inc., Arlington

DATE _____

TOWN OF LEXINGTON—BOARD OF PUBLIC WORKS

WATER DIVISION

The undersigned applies for a supply of water at No. _____ St. and hereby agrees to comply with the rules and regulations as now, or at any future time, established by the Board of Selectmen.

Am't. of Estimate \$ _____


Owner _____

Am't. Paid \$ _____

Address _____

Builder _____

Sketch of Service Here

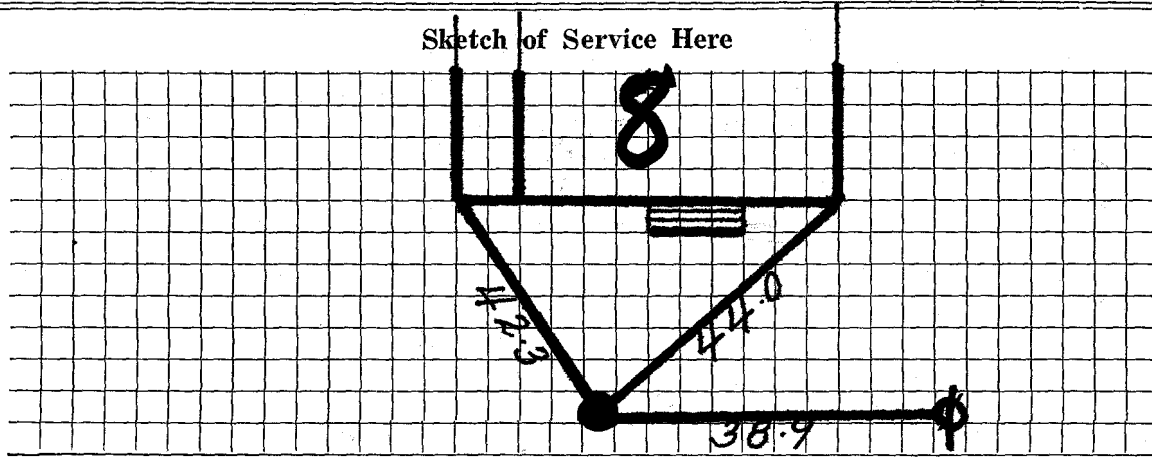

Connection made in _____ Street.

Work completed _____ 19

Remarks: