


DATE 7/31/18

TOWN OF LEXINGTON — BOARD OF PUBLIC WORKS

WATER DIVISION

Sketch of Service Here

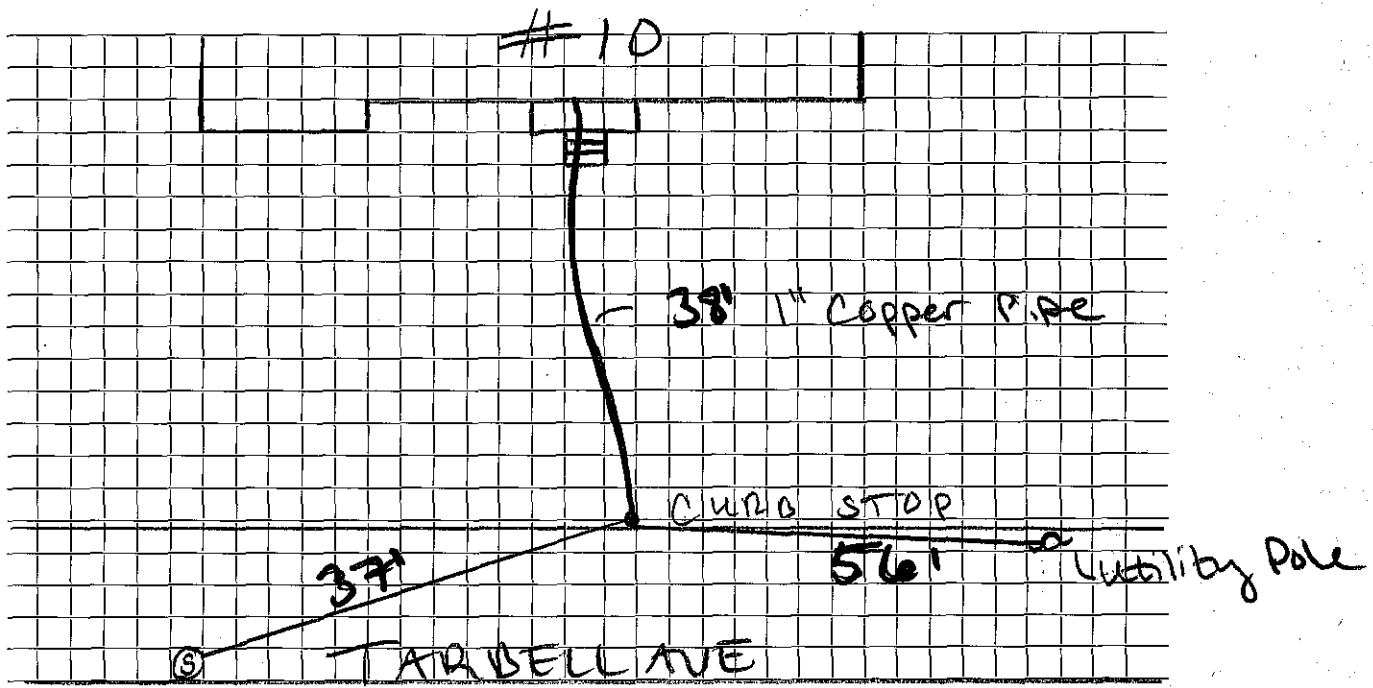

Connection made in Tarbell Ave Street. Work completed

Remarks: