

WATER SERVICE RECORD

Name Richard Hamilton

Service No. 75

Address 15 Tarbell Avenue

Location

~~REPAIRS~~ New Service

Comm 7-12-61


Date	Material	Amount	Total	Date	Amount	
6-12-61	Labor	2.15		6-2-61	Deposit	50.00
	10% O.H.	.22	2.37	7-12-61	Refund	22.56
45'	3/4" Copper Tubing @.42		18.90			27.44
1	3/4" C x 1/2 I.W.H. Stop & Waste		6.17			
			27.44		NON CHARGE	
				6-12-61	Labor	2.04
					19' 3/4" Copper Tubing @.42	7.98
					1 3/4" C Corp Cook	4.91
					1 3/4" C Curb Cook	6.28
					1 Box & Rod	4.90
					1 1/2 Straight tailpiece	.50
					1 1/2 Offset tailpiece	.50
						27.11

DATE _____

TOWN OF LEXINGTON — BOARD OF PUBLIC WORKS

WATER DIVISION

Sketch of Service Here

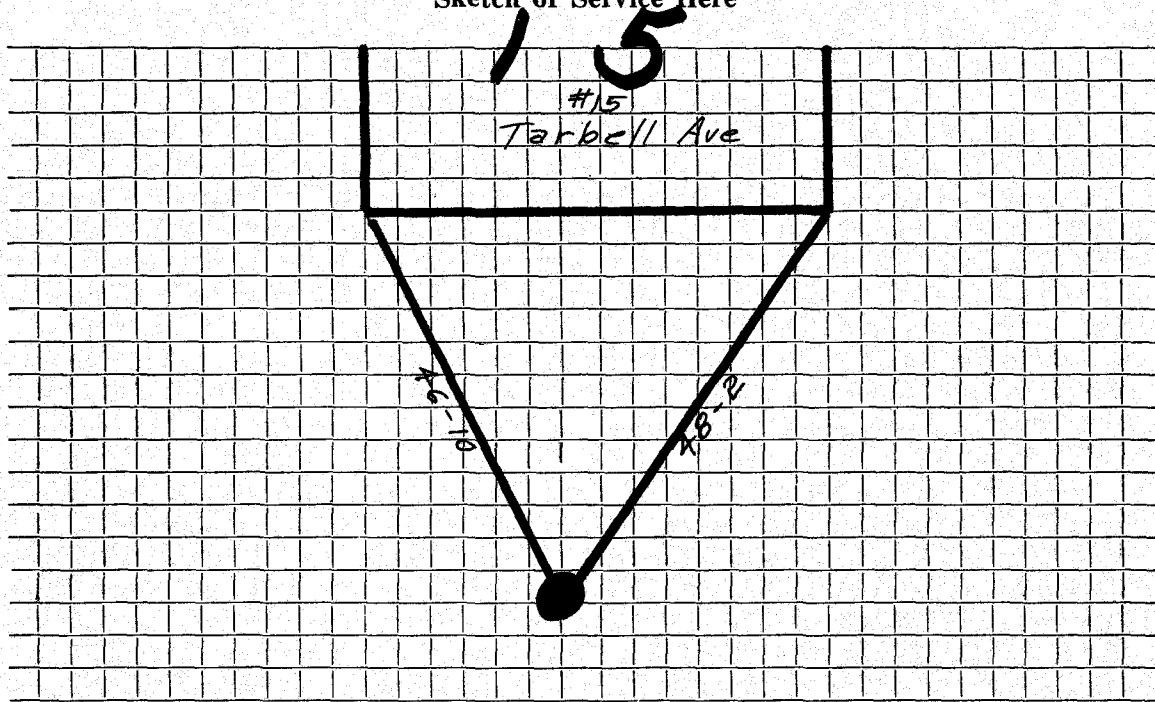

Connection made in Street. Work completed

Remarks:

.....

.....