

## WATER SERVICE RECORD

# 5672

Name Richard Hamilton

Service No. 203

Address 17 Tarbell Avenue

Location

~~Repair~~ - New Service

Com. 11-21-60


Date	Material	Amount	Total	Date	Amount
10-3-60	Labor	2 05		9-22-60	50 00
	10% O.H.	21	2 26	11-21-60	33 75
	42' 3/4" Copper tubing @42		17 64		26 87
	1 3/4" Cx 1/2 I.W.H. Stop&Waste		6 17		
			26 07		
					NON CHARGE
				10-3-60	Labor 1 75
					17' 3/4" Copper tubing@42 7 14
					1 3/4" CCorp Cock 4 91
					1 3/4" CCurb Cock 6 28
					1 Box & Rod 4 90
					1 1/2 Straight tailpiece 50
					1 1/2 Offset tailpiece 50
					25 98

DATE \_\_\_\_\_

TOWN OF LEXINGTON — BOARD OF PUBLIC WORKS

WATER DIVISION

Sketch of Service Here

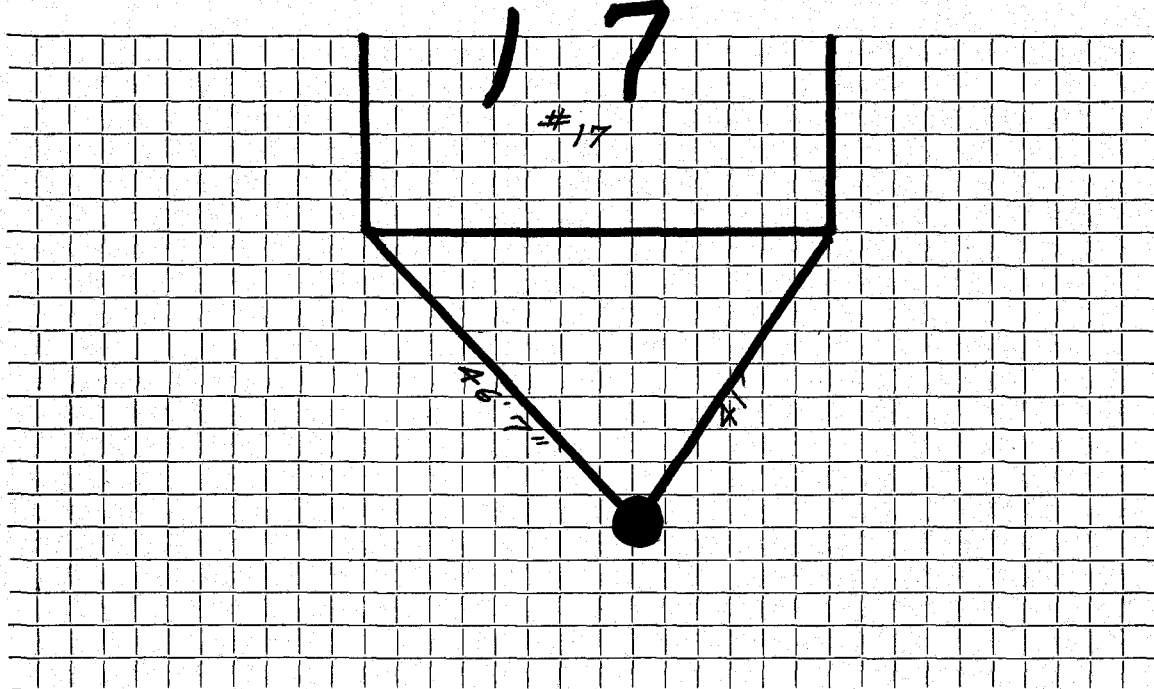

Connection made in ..... Street. Work completed .....

Remarks: .....  
.....  
.....