

WATER SERVICE RECORD

#5383

Name Michael Graziano

Service No. 205

Address 32 Tarbell Avenue

Location

~~Renewal~~ New Service

Comm 11-11-60

Date	Material	Amount	Total	Date	Amount	
10-5-60	Labor	47.82		9-23-60	Deposit	100.00
	10% O.H.	4.78	52.60	12-13-60	Paid	12.39
63'	3/4" Copper tubing @.42		26.46			112.39
1	3/4" C x 1/2 I.W.H. Stop & Waste		6.17		NON CHARGE	
1	3/4" C 3 part union		2.41	10-5-60	Labor	6.83
1 1/2	hrs. Town Shovel @6.50		9.75	9'	3/4" Copper tubing @.42	3.78
2	hrs. Rogers Trailer @3.00		6.00	1	3/4" C Corp Cock	4.91
1	hr. Allis Chalmer @3.00		3.00	1	3/4" C Curb Cock	6.28
2	hrs. Trucking @3.00		6.00	1	Box & Rod	4.90
			112.39	1/2	hr. Town Shovel @6.50	3.25
				1	1/8 Straight tailpiece	.50
				1	1/8 Offset tailpiece	.50
						30.95


Bill sent 11-14-60 12.39

DATE _____

TOWN OF LEXINGTON — BOARD OF PUBLIC WORKS

WATER DIVISION

Sketch of Service Here

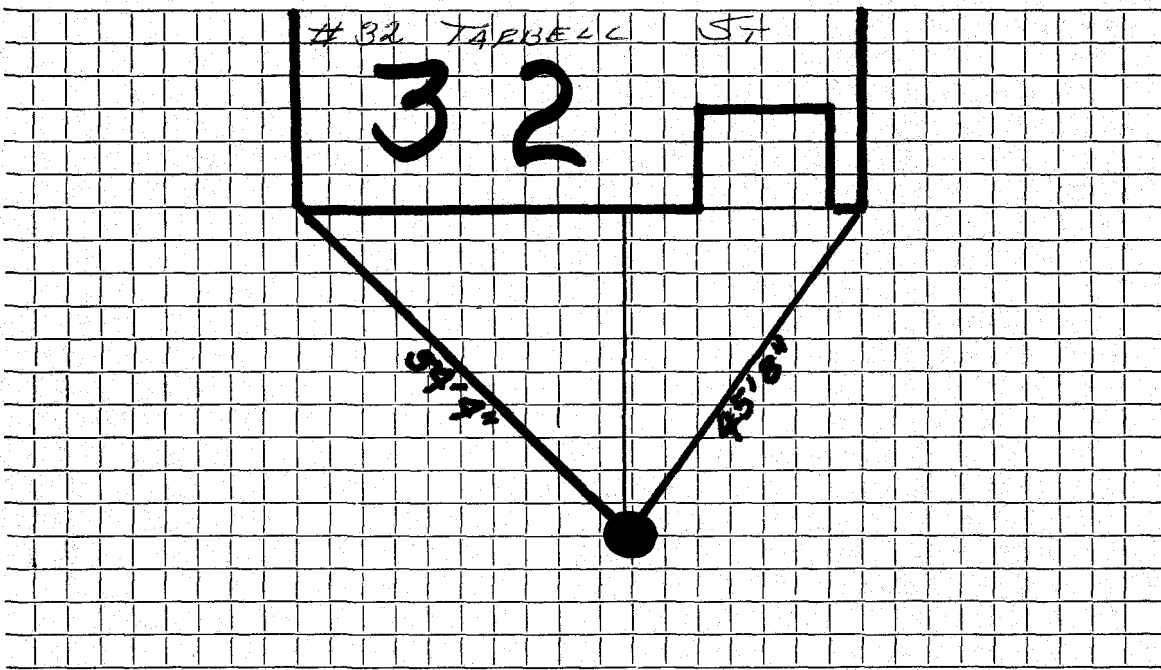

Connection made in Street. Work completed

Remarks:
.....
.....