

WATER SERVICE RECORD

Name **William Catley**

Service No. **336**

Address **37 Tarbell Avenue**

Location **Lexington**

# 440


~~Repair~~ - New Service

COML 12-31-52

Date	Material	Amount	Total	Date	Amount
12/31/52	Labor	10 00		12-9-52 Deposited	50 00
	10% overhead	1 00	11 00	12-31-52 Refunded	1 55
	55' - 3/4" copper tubing @ .34		18 70		<u>NON CHARGE</u> 48 45
	2 hrs. Littlefield shovel @ 7.00		14 00	12/31/52 Labor	16 46
	1 - stop and waste		4 00	20' - 3/4" copper tubing @ .34	6 80
	1 hr. trucking		75		
			48 45	1 - 3/4" C. corp-cock	4 33
				1 - 3/4"C x 3/4"C. curb-cock	4 67
				1 box and rod	3 90
				1 - 1/2 straight tail pc.	50
				1 - 1/2 offset tail pc.	50
				2 hrs. Littlefield shovel	14 00
				1 hr. trucking	75
					<u>51 91</u>

TOWN OF LEXINGTON — BOARD OF PUBLIC WORKS  
WATER DIVISION

Sketch of Service Here

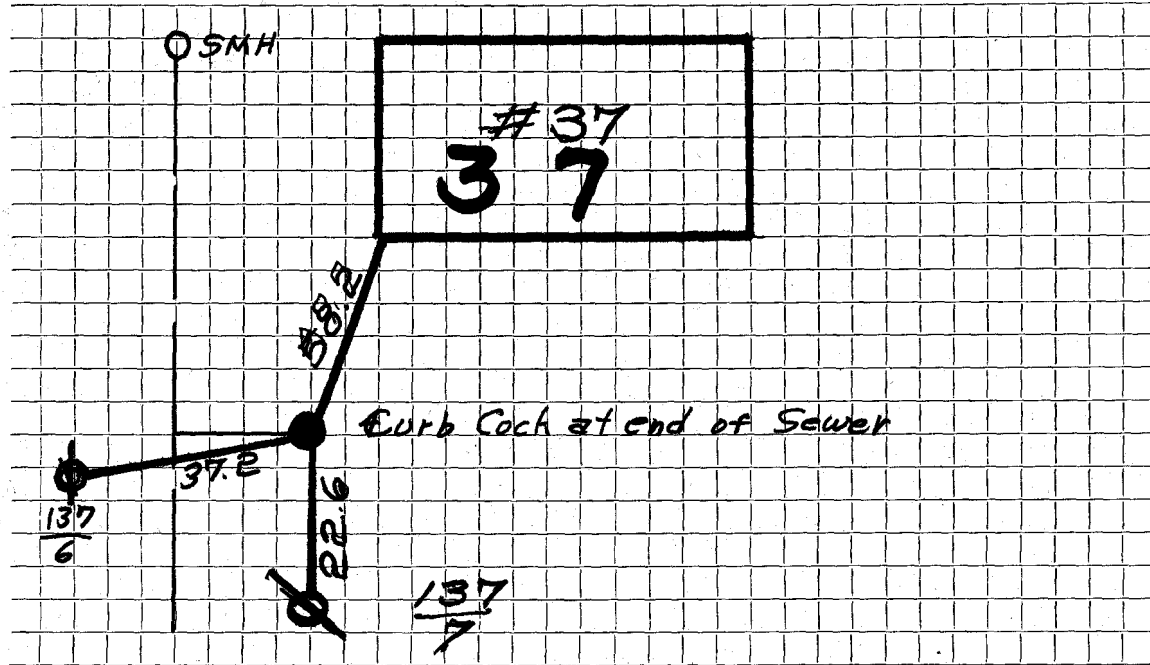

Connection made in ..... Street. Work completed .....

Remarks: .....

.....

.....