


DATE 9-12-90

TOWN OF LEXINGTON — BOARD OF PUBLIC WORKS

WATER DIVISION

Sketch of Service Here

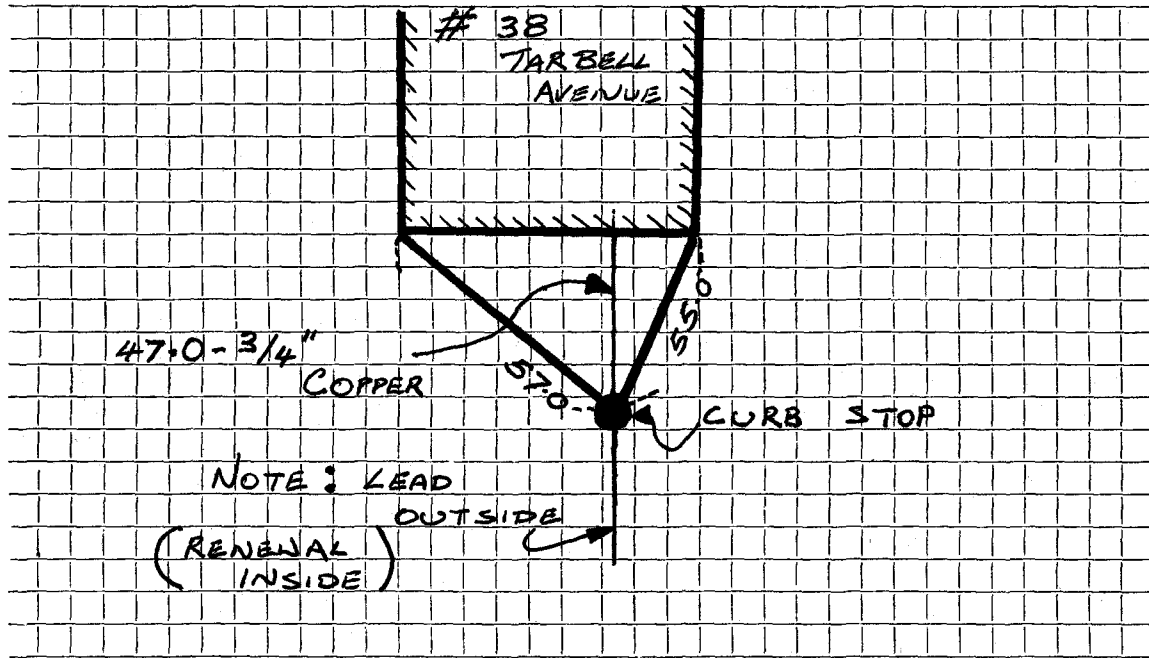

Connection made in TARBELL AVENUE Street. Work completed

Remarks:
.....
.....