

WATER SERVICE RECORD

Name Oscar Carlson

Service No. 285

Address 41 Tarbell Avenue

219

Location Lexington

239

~~Repair~~ ~~Renewal~~ - New Service COM. 12-8-52


Date	Material	Amount	Total	Date	Amount
11/4/52	Labor	10 04		10-28-52 Deposited	45 00
	10% overhead	1 00	11 04	12-8-52 Refunded	(9 93)
	42' -3/4" copper tubing@.34		14 28		NON CHARGE
	1 -3/4"Cx 1/2 I.W.H. stop&waste		4 00	11/4/52 Labor	10 04
	1 hr. town shovel		5 00	18' -3/4" Copper tubing@.34	6 12
	1 hr. trucking		75	1 -3/4" C. corp-cock	4 33
			35 07	1 -3/4"C x 3/4" C. curbcock	4 67
				1 box and rod	3 90
				1 -1/2 straight tail pc.	50
				1 -1/2 offset tail piece	50
				1 hr. town shovel	5 00
				1 hr. trucking	75
					<u>35 81</u>

DATE _____

TOWN OF LEXINGTON — BOARD OF PUBLIC WORKS

WATER DIVISION

Sketch of Service Here

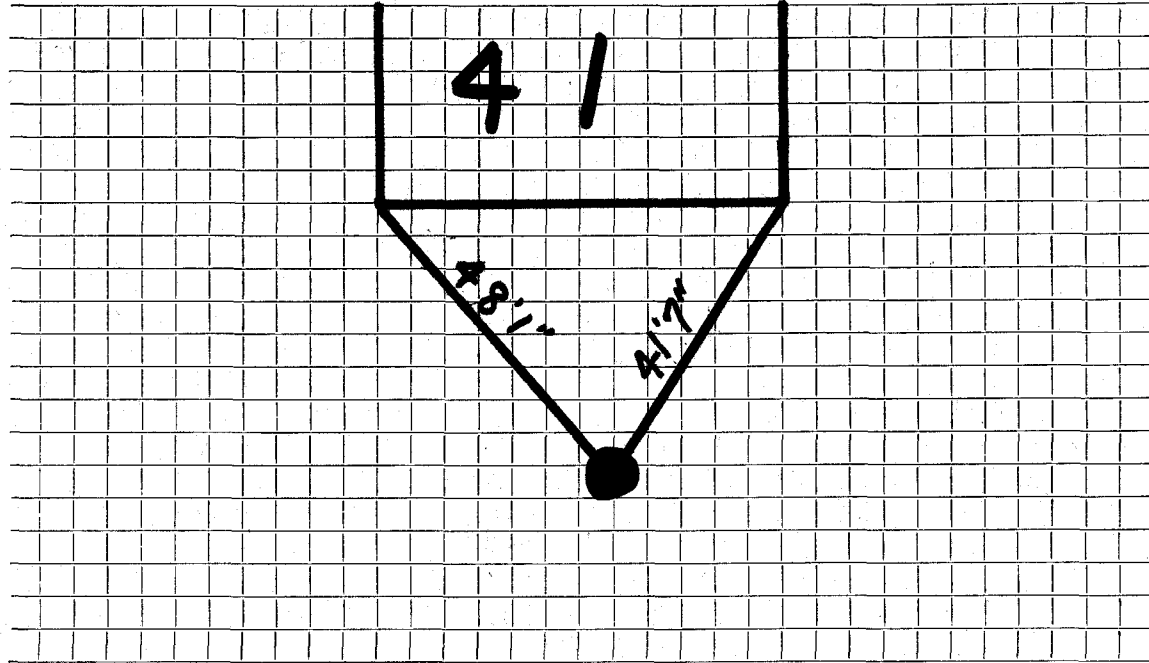

Connection made in Street. Work completed

Remarks:

.....
.....