

Name James H. Wichman

Service No. 2659 #25

Address 44 Tarbell Avenue # 2855

Location 44 Tarbell Ave.

Kind of Pipe

Size

Size of Main

~~Repair—Renewal—New Service~~ W.O. #3342. Connection #25.

Location *Con 7-28-75*

Date	Material	Amount	Total	Date	Amount
5-20-75	Labor	75.95		5-13-75	300.00
	10 % O.H.	<u>7.60</u>	\$83.55	6-28-75	119.91
60'	3/4" Copper Pipe @1.01		60.60		180.89
1	3/4 x 3/4 Wheel Valve		15.48		
1	3/4 Bushing		1.46		
2	Hrs. Trucking @3.00		6.00		
2	Hrs. Backhoe @6.50		<u>13.00</u>		
			\$180.09		
	Labor				

*Deposit  
Retard*

Hadley Press, Inc., Lexington

DATE \_\_\_\_\_

# TOWN OF LEXINGTON—BOARD OF PUBLIC WORKS

## WATER DIVISION

The undersigned applies for a supply of water at No. \_\_\_\_\_ St. and hereby agrees to comply with the rules and regulations as now, or at any future time, established by the Board of Selectmen.

Am't. of Estimate \$ \_\_\_\_\_

Owner


August Nickerson

Am't. Paid \$ \_\_\_\_\_

Address

44 Tarbell Ave.

Builder \_\_\_\_\_

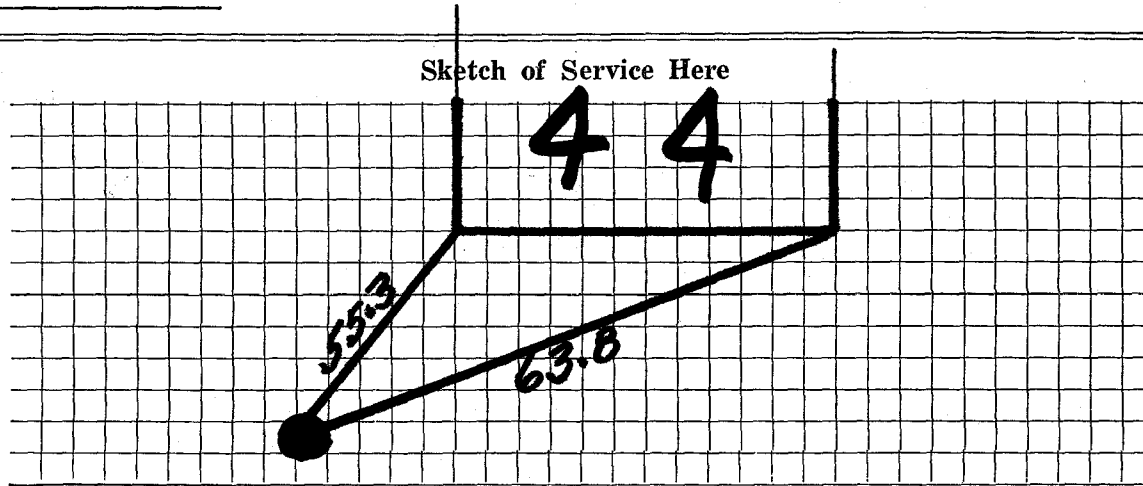

Connection made in \_\_\_\_\_ Street.

Work completed \_\_\_\_\_ 19

Remarks: