

**WATER SERVICE RECORD**

Name

Service No.

Address

57 TARBELL AVE

Location

Repair—Renewal—New Service

RENEWAL


Date	Material	Amount	Total	Date	Amount
<del>10-94</del>	<del>19' of 1" COPPER</del>				
	<del>1-1" CURB COCK</del>				
	<del>1-1" x 3/4" REDUCER</del>				
6-15-83	26' 3/4" Copper			10-94	
				19' 1" Copper	
				1 1" Curb Cock	
				1 1" Corp Cock	
				1 1" c. x 3/4" c. Reducer	
				1 Box	

DATE 10/94

TOWN OF LEXINGTON — BOARD OF PUBLIC WORKS

WATER DIVISION

Sketch of Service Here

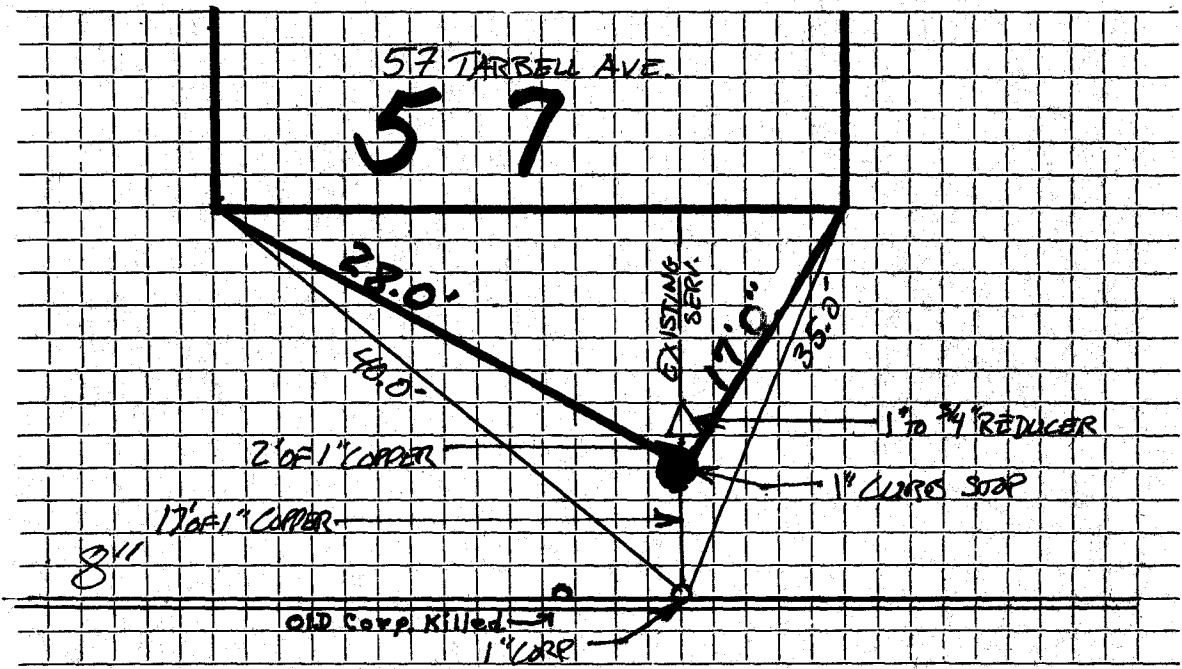

Connection made in ..... Street. Work completed .....

Remarks: .....

.....

.....