

WATER SERVICE RECORD

#6509

Name William Sullivan

Service No. 273

Address 59 Tarbell Avenue

Location

Repair—Renewal—New Service


Comm. 12/31/57

Date	Material	Amount	Total	Date	Amount
11/22/57	Labor	3 52		11-19-57	Deposit \$ 50 00
	10% overhead	35	3 87	12-31-57	Refund 25 62
	40' - 3/4" Copper tubing @ .37	14 80			NON CHARGE \$ 24 38
	1 - 3/4" Cx 1/2 I.W.H. Stop & Waste	4 96		Labor	3 52
	1 hr. Trucking		75	33' - 3/4" Copper tubing @ .37	12 21
			24.38	1 - 3/4" C. Corp Cock	4 64
				1 - 3/4" C. Curb Cock	5 94
				1 Box & Rod	4 62
				1 - 1/2 Straight tailpiece	50
				1 - 1/2 Offset tailpiece	50
					31 93
				* Applied to S.A.C. #219 - \$25.62	

DATE _____

TOWN OF LEXINGTON — BOARD OF PUBLIC WORKS
WATER DIVISION

Sketch of Service Here

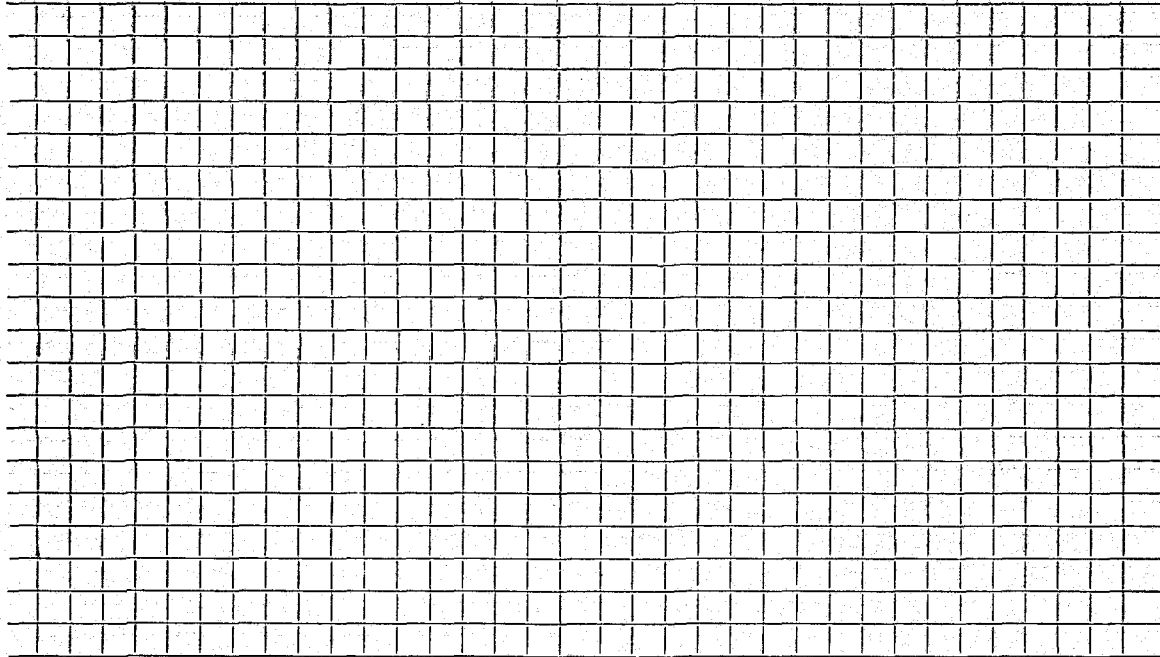

Connection made in Street. Work completed

Remarks:
.....
.....