

WATER SERVICE RECORD

Name

Service No.

Address **60 TARBELL AVE**

Location

Repair—Renewal—New Service **RENEWAL**


Date	Material	Amount	Total	Date	Amount
10-94	12' of 1" COPPER				
	1" CURB STOP				
	1" x 3/4" REDUCER			10- - '94'	
6-29-'55'				12' 1" Copper	
	32' 3/4" Copper			1 1" Corp Cock	
	1 3/4" C. X 1/2" I.W.H. STOP + WASTE			1 1" Curb Cock	
				1 1" C. X 3/4" C. Reducer	
				1 Box + Rod	

DATE 10/94

TOWN OF LEXINGTON — BOARD OF PUBLIC WORKS

WATER DIVISION

Sketch of Service Here

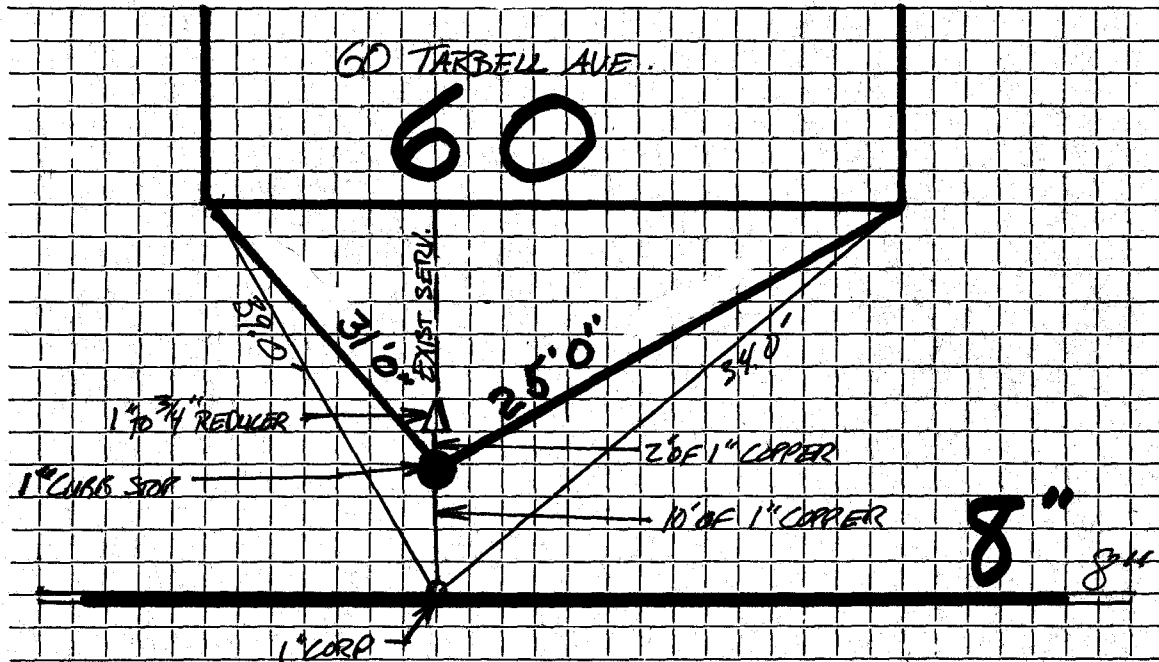

Connection made in Street. Work completed

Remarks:
.....
.....