

Name **George E. Rowe**

WATER SERVICE RECORD

Service No. **270**

Address **7 Farbell Ave/**

# **6848**

Location **Lexington**

~~Repair~~ ~~Renewal~~ ~~NEW SERVICE~~

*Com. 11-3-52*

Date	Material	Amount	Total	Date	Amount
9/17/52	Labor	4 65			
	10% Overhead	47	5 12		
	26' - 3/4" Coppertubing @.34		8 84		
	1 - 3/4" C x 1/2 I.W.H. stop & waste	4 00			
	1 hr. town shovel @5.00		5 00	9/17/52	Labor 8 58
	1 hr. trucking		75	21' - 3/4" Copper tubing @.34	7 14
			23 71	1 - 3/4" C. corp-cock	4 33
				1 - 3/4" C x 3/4" C. curb-cock	4 67
				1 box and rod	3 90
				1 - 1/2 straight tail piece	50
				1 - 1/2 offset tail piece	50
				1 hr. town shovel 5.00	5 00
				1 hr. trucking	75
					<u>35 37</u>

*No deposit Paid*

**NON CHARGE**


*bill sent 11-5-52*

DATE \_\_\_\_\_

TOWN OF LEXINGTON — BOARD OF PUBLIC WORKS

WATER DIVISION

Sketch of Service Here

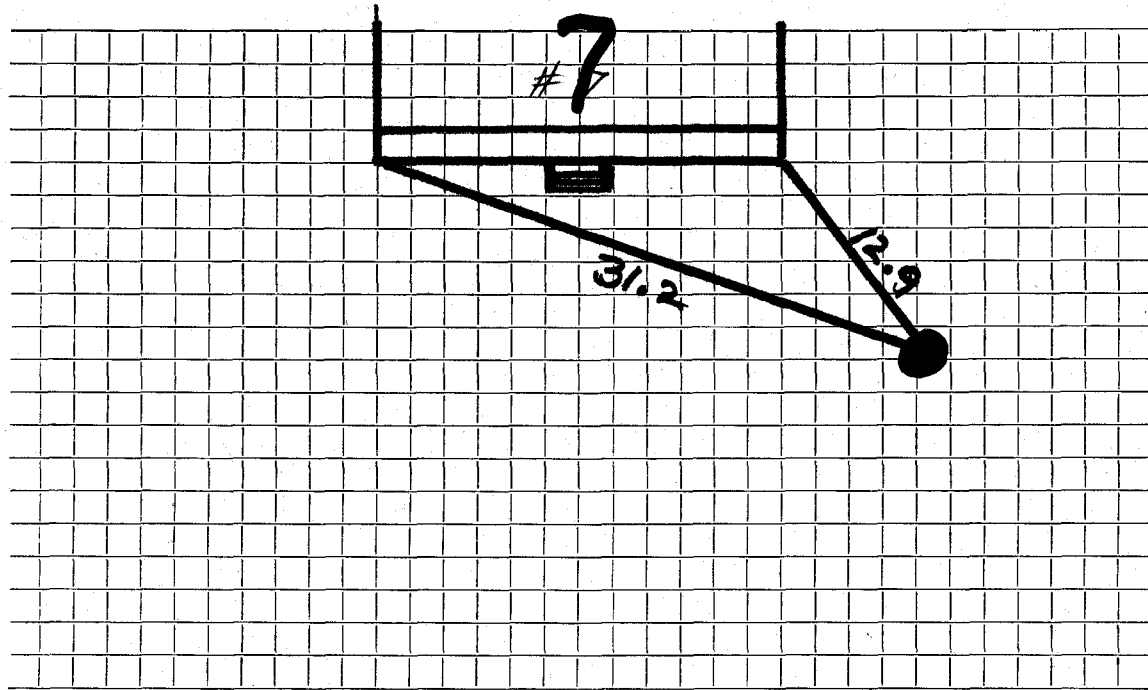

Connection made in ..... Street.                      Work completed .....

Remarks: .....

.....

.....