

Name Josephine Berglund

Service No.

122

Address 5 Tavern Lane

Lexington

Location 5 Tavern Lane

Kind of Pipe

Size

Size of Main

~~Repair - Run-out~~ - New Service

Com. 9-5-50

Location

Date	Material	Amount	Total	Date	Amount
July 5 '50	Labor	3 00		June 9 '50	8 00
	10% Overhead	30	3 30	Reported	
	224' - 3/4" Copper Tubing @ 23¢	51 52			68 03
	1 - 3/4"C x 1/2" I.W.H. S&W	3 29		No Charge	
	1 hr. Trucking		75	July 5 '50 Labor	1 50
	3 - 3/4"C x 3/4"C. Union (3pts)	4 17		14' - 3/4" Copper Tubing @ 23¢	3 22
			63 03	1 - 3/4"C. Corp-cock	3 15
				1 - 3/4"C x 3/4"C Curb-cock	3 85
				1 Box & Rod	3 35
				1 - 1/2" Straight Tail Piece	38
				1 - 1/2" Offset Tail Piece	38
				1 hr. Trucking	75
	Labor				16 58

# TOWN OF LEXINGTON - BOARD OF PUBLIC WORKS

## WATER DIVISION

The undersigned applies for a supply of water at No..... St. and hereby agrees to comply with the rules and regulations as now, or at any future time, established by the Board of Selectmen.

Am't of Estimate \$.....

Owner .....


Am't Paid \$.....

Address .....

Builder .....

.....

Sketch of Service Here

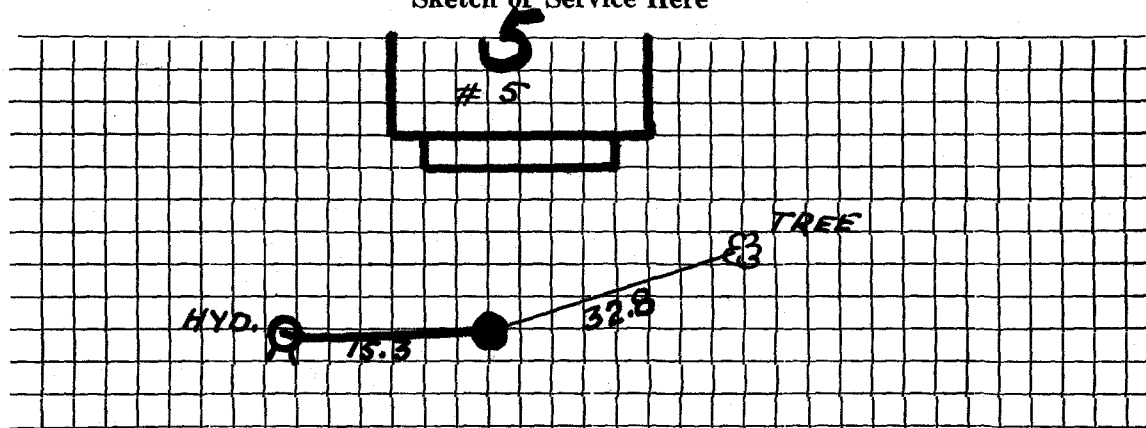

Connection made in ..... Street.

Work completed .....19

Remarks: