

WATER SERVICE RECORD

Name Dr. Rufus Partlow

Service No.

Address 7 Tavern Lane

Location


~~Repair-Renewal~~—New Service Arlex Oil #3561

DATE _____

TOWN OF LEXINGTON — BOARD OF PUBLIC WORKS

WATER DIVISION

Sketch of Service Here

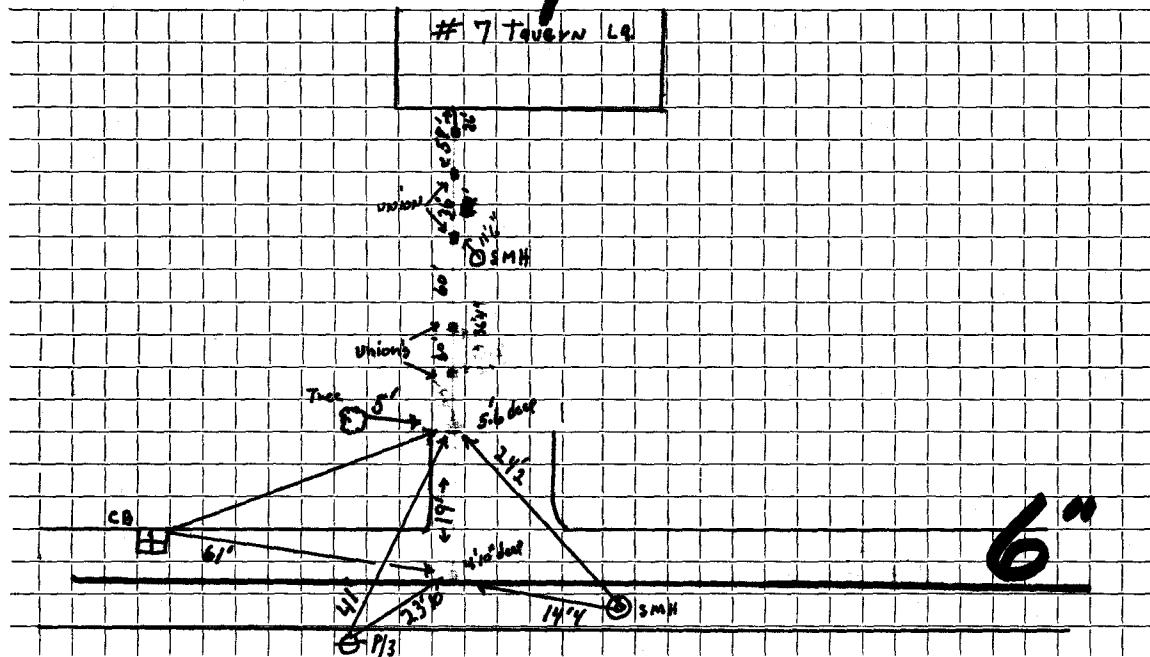

Connection made in Tavern Lg., 19' off copper outside Street.

Work completed

Remarks: Water is to left. of Sewer. Side by side.....