

WATER SERVICE RECORD

#5088

Name Mark Moore

Service No. 87

Address 9 Tavern Lane

Location

~~Repair - Renewal~~ New Service


Comm. 7/22/57

Date	Material	Amount	Total	Date	Amount
5/8/57	Labor	1 76		5-10-57	Deposit 50 00
	10% overhead	17	1 93	7-22-57	Refund 8 90
	72' - 3/4" Copper tubing @ .4228	30 44			NON CHARGE 41 10
	1 - 3/4" Cx 1/2 I.W.H. Stop & Waste	4 96			Labor 1 76
	1 - 3/4" Union (3 part)	2 27			15' - 3/4" Copper tubing @ .4228 6 34
	2 hrs. Trucking @ .75	1 50			1 - 3/4" C. Corp Cock 4 64
			41 10		1 - 3/4" C. Curb Cock 5 94
					1 Box & Rod 4 62
					1 - 1/2 Straight tailpiece 50
					1 - 1/2 Offset tailpiece 50
					<u>24 30</u>

TOWN OF LEXINGTON — BOARD OF PUBLIC WORKS

WATER DIVISION

Sketch of Service Here

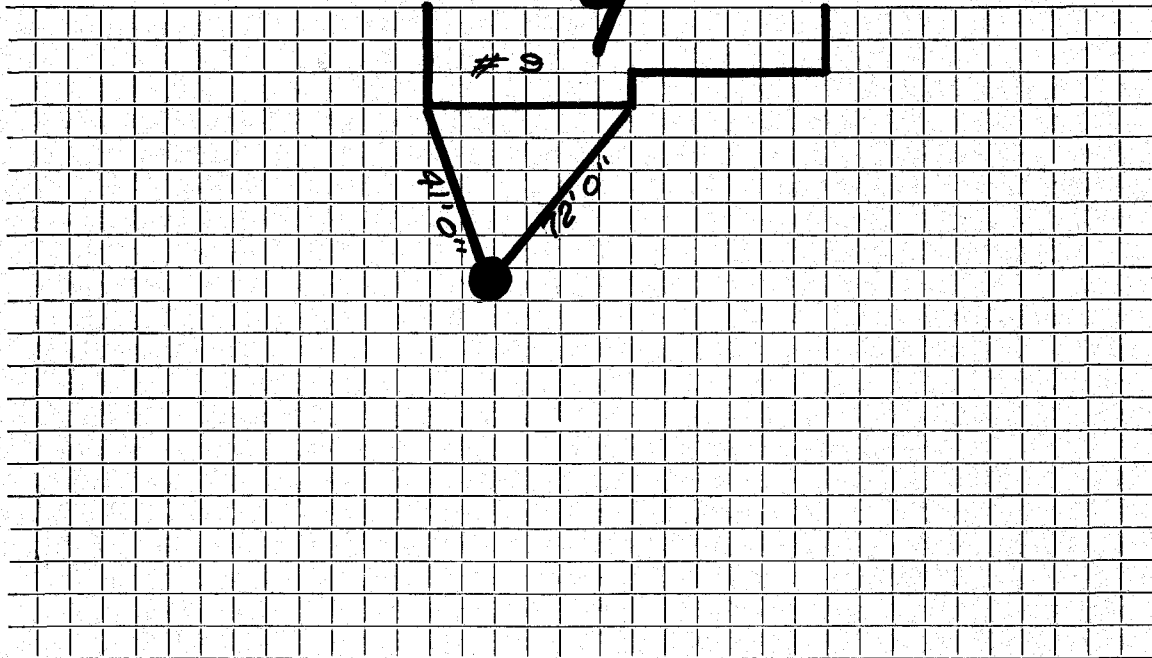

Connection made in Street. Work completed

Remarks:
.....
.....