




DATE \_\_\_\_\_

TOWN OF LEXINGTON — BOARD OF PUBLIC WORKS  
**WATER DIVISION**

Sketch of Service Here

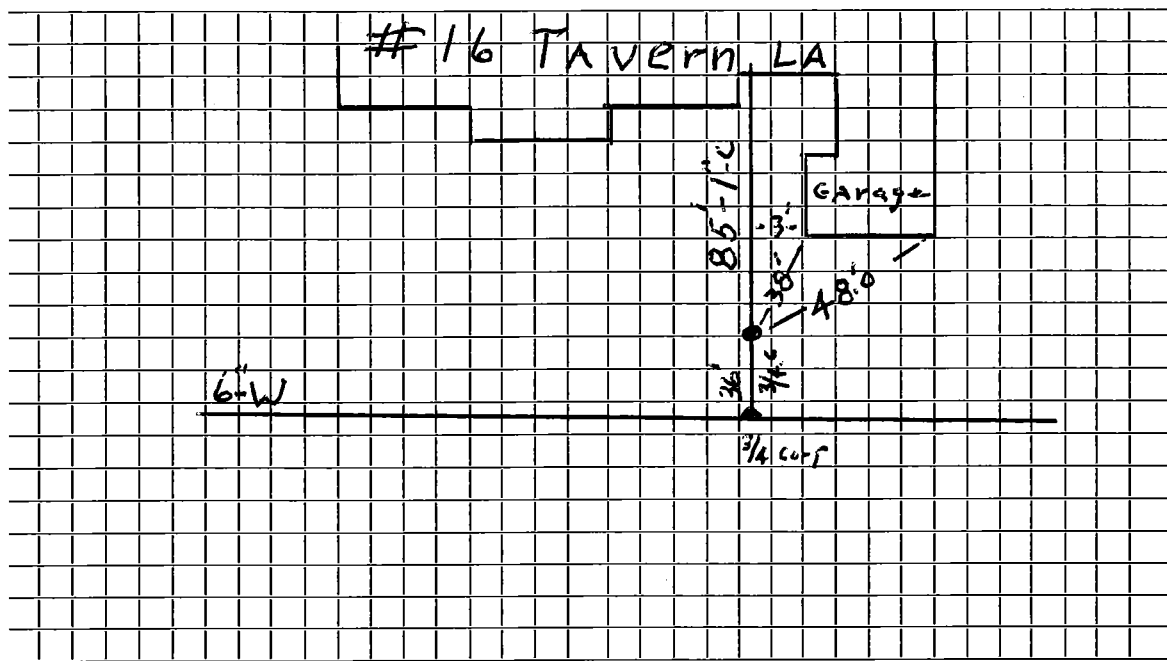

Connection made in..... Street.

Work completed 4/25/10..... J. McLaughlin.

Remarks:.....  
.....  
.....