

WATER SERVICE RECORD

Name Woodhaven Realty Trust

Service No.

Address #1 TAYLOR LANE

Location

Lot 1

Repair—Renewal—New Service McLaughlin


Date	Material	Amount	Total	Date	Amount
10-31-91	12' 1" COPPER				
	1" CORR.				
	1" CURB BOX			10-31-91	
				12' 1" Copper	
				1 1" Corp Cock	
				1 1" Curb Cock	
				1 Box	

DATE _____

TOWN OF LEXINGTON — BOARD OF PUBLIC WORKS

WATER DIVISION

Sketch of Service Here

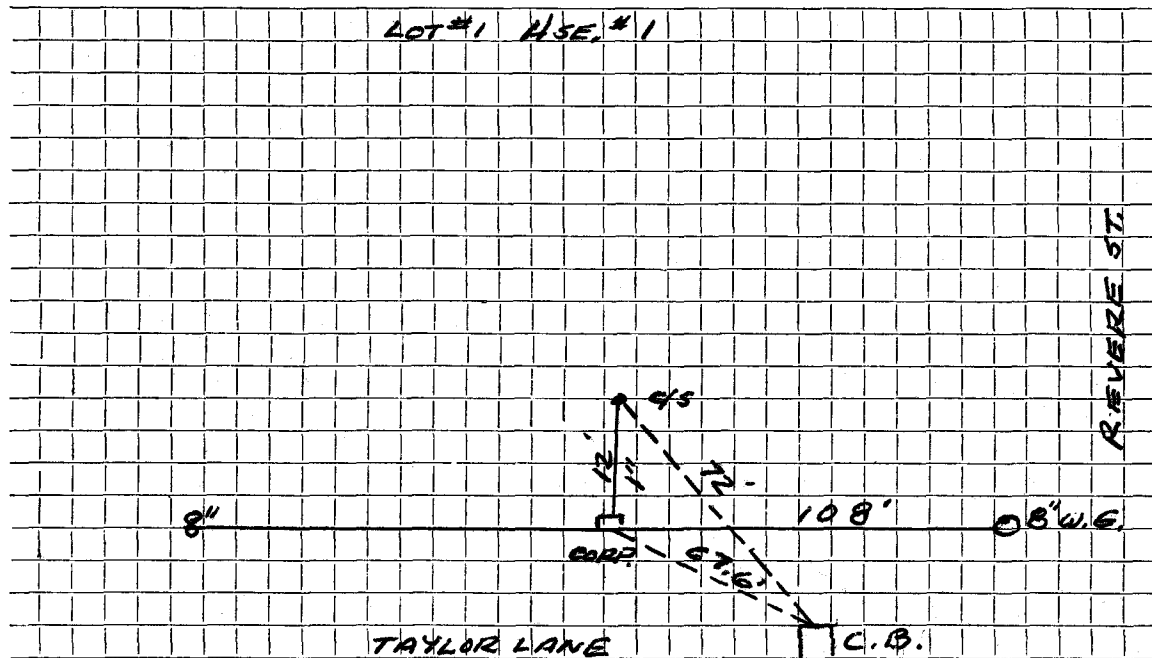


Connection made in TAYLOR LANE Street. Work completed

Remarks: SUB-DIV.

TOWN OF LEXINGTON — BOARD OF PUBLIC WORKS

WATER DIVISION

Sketch of Service Here

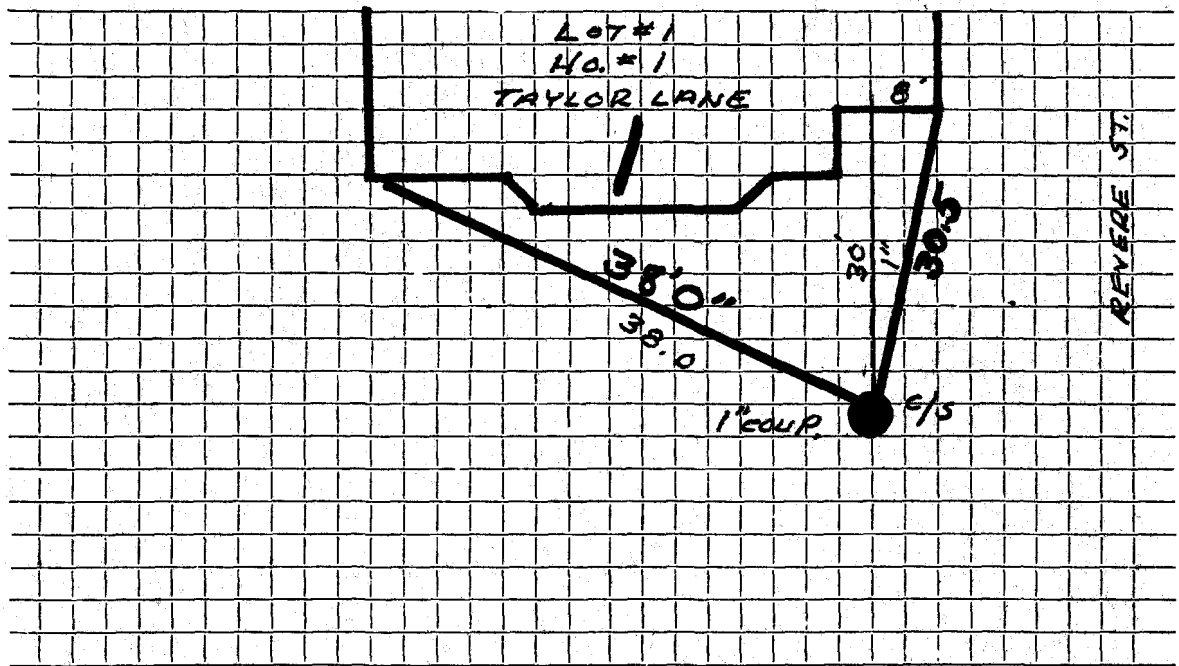

Connection made in TAYLOR LANE Street. Work completed

Remarks:

.....

.....