

WATER SERVICE RECORD

Name Woodhaven Realty Trust

Service No.

Address # 3 TAYLOR LANE

Location

Lot 2

Repair—Renewal—New Service

McLaughlin

Date		Material	Amount	Total	Date	Amount
10-30-	91	12 LF 1" COPPER				
		1" CORP.				
		1" CURB w/BOX			10-30-'91	
					12' 1" Copper	
					1 1" Corp Cock	
					1 1" Curb Cock	
					1 Box	


DATE _____

TOWN OF LEXINGTON — BOARD OF PUBLIC WORKS

WATER DIVISION

Sketch of Service Here

LOT #2 HSE # 3

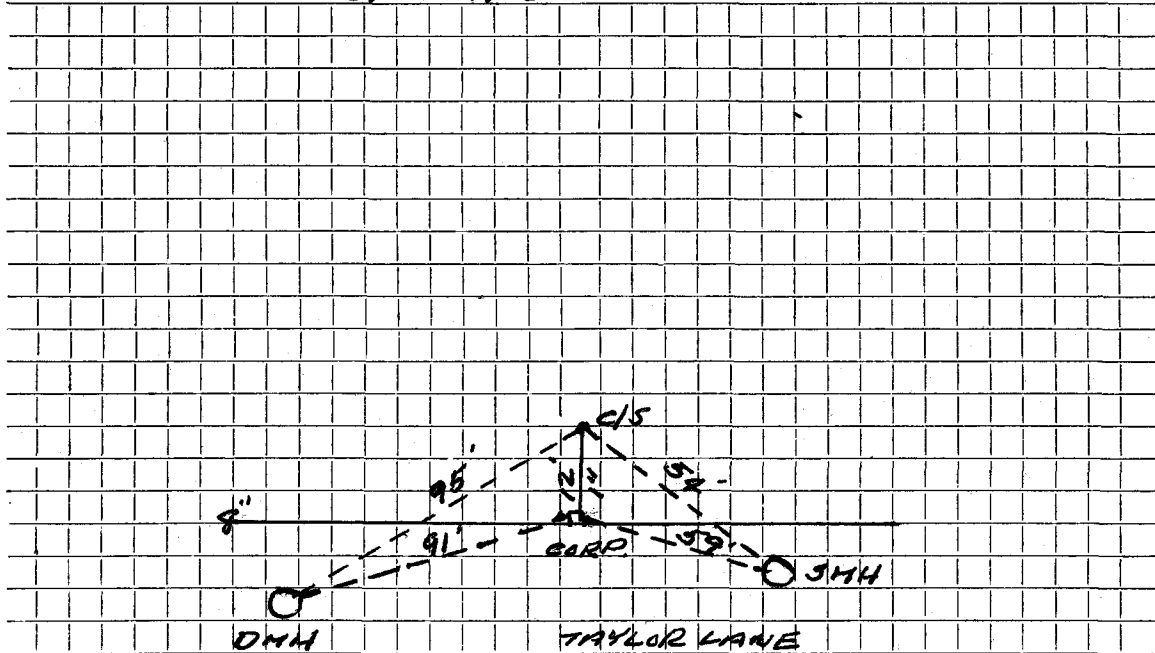

Connection made in TAYLOR LANE Street. Work completed


Remarks:
.....
.....

DATE _____

TOWN OF LEXINGTON — BOARD OF PUBLIC WORKS

WATER DIVISION

Sketch of Service Here

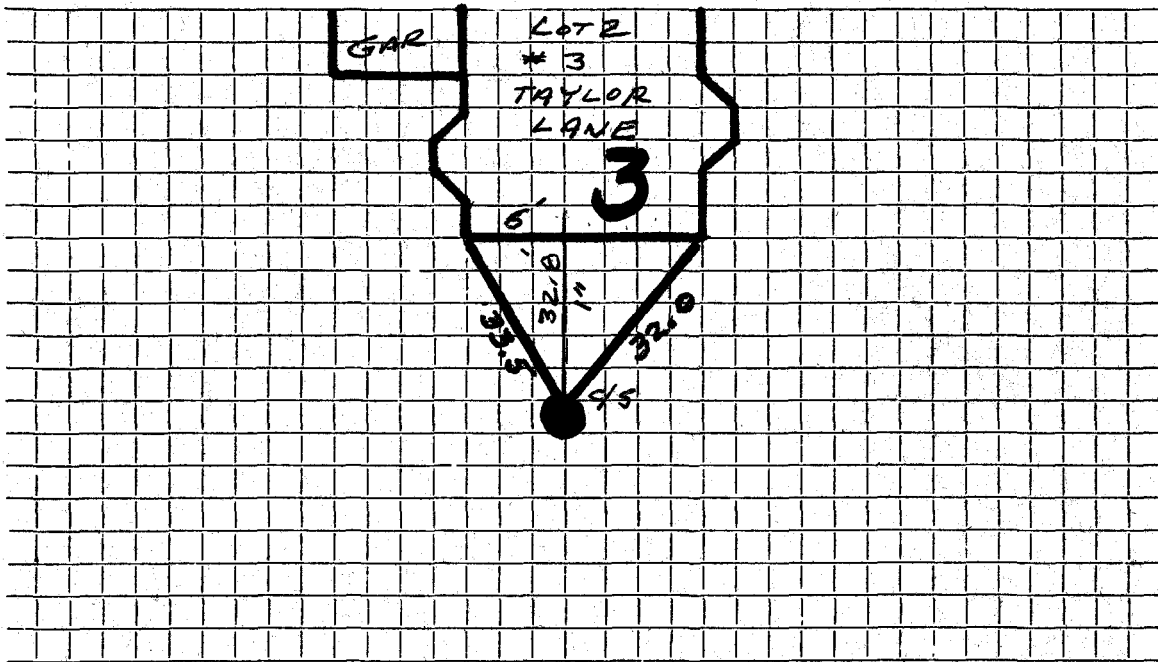

Connection made in TAYLOR LANE Street. Work completed

Remarks:

.....

.....