

WATER SERVICE RECORD

Name Woodhaven Realty Trust

Service No.

Address 7 TAYLOR LANE

Location Lot 4

Repair—Renewal New Service

McLaughlin #151


Date	Material	Amount	Total	Date	Amount
10-30-91	41' 1" COPPER				
	1" CORP.				
	1" CURB W/BOX			10-30-91	
				41' 1" Copper	
				1 1" Corp Cock	
				1 1" Curb Cock	
				1 Box	

DATE _____

TOWN OF LEXINGTON — BOARD OF PUBLIC WORKS

WATER DIVISION

Sketch of Service Here
LOT #4 USE # 7

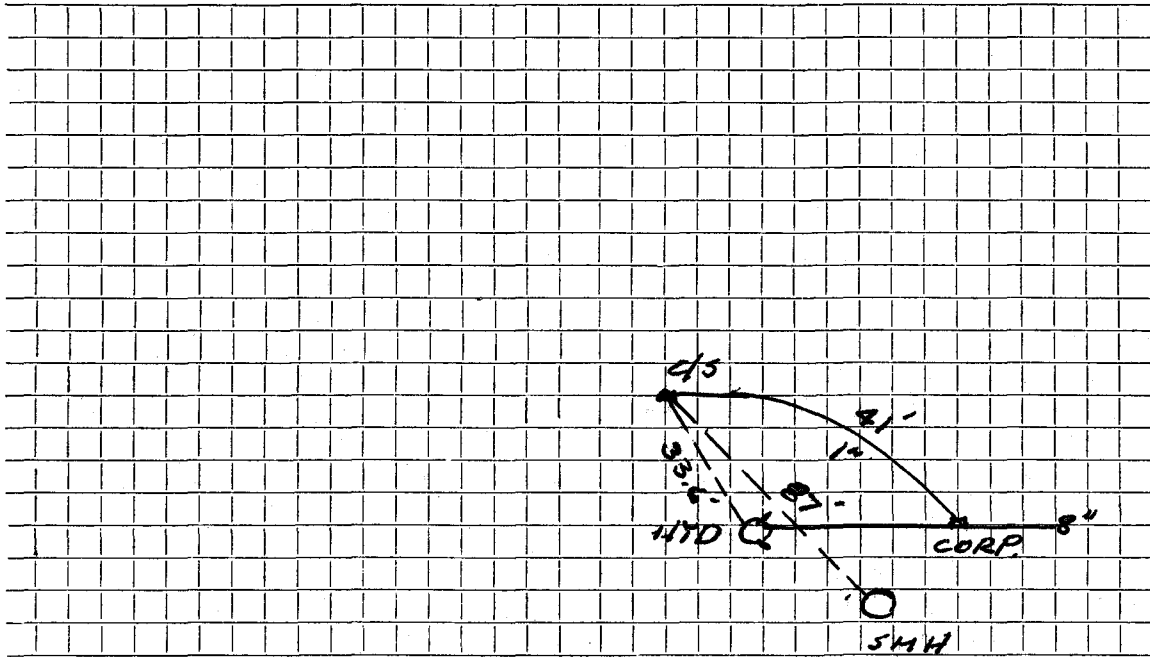

Connection made in TAYLOR LANE Street. Work completed

Remarks:
.....
.....