

WATER SERVICE RECORD

Name Eliza Bettencourt

Service No. 120

Address 4 Tewksbury Street

2297

Location

6971

~~Repair~~ Renewal ~~New Service~~ W.O. #9298

DEC 28 1964


Date	Material	Amount	Total	Date	Amount
10-27-64	Labor	41 05		10-13-64	Deposit 300 00
	10% O.H.	4 11	45 16	2-22-74	Returned 144 45
83'	3/4" Copper tubing @.42		34 86		115 55
1	3/4" CX 1/2 I.W.H. Stop & Waste		9 26		
2	3/4" C3 Part Unions @3.01		6 02		NON CHARGE
2	Yds. Loam @3.00		6 00	10-27-64	Labor 7 38
1 1/2	Hrs. Town Shovel @6.50		9 75	4'	3/4" Copper tubing 1 68
1 1/2	Hrs. Trucking @3.00		4 50	1	3/4" C Curb Cock 8 76
			115 55	1/2	Hr. Town Shovel @6.50 3 25
				1/2	Hr. Trucking @3.00 1 50
				1	1/2 Straight tailpiece 50
					23 07
				11-23-74	Repair Broken Water Sewer

DATE _____

TOWN OF LEXINGTON — BOARD OF PUBLIC WORKS

WATER DIVISION

Sketch of Service Here

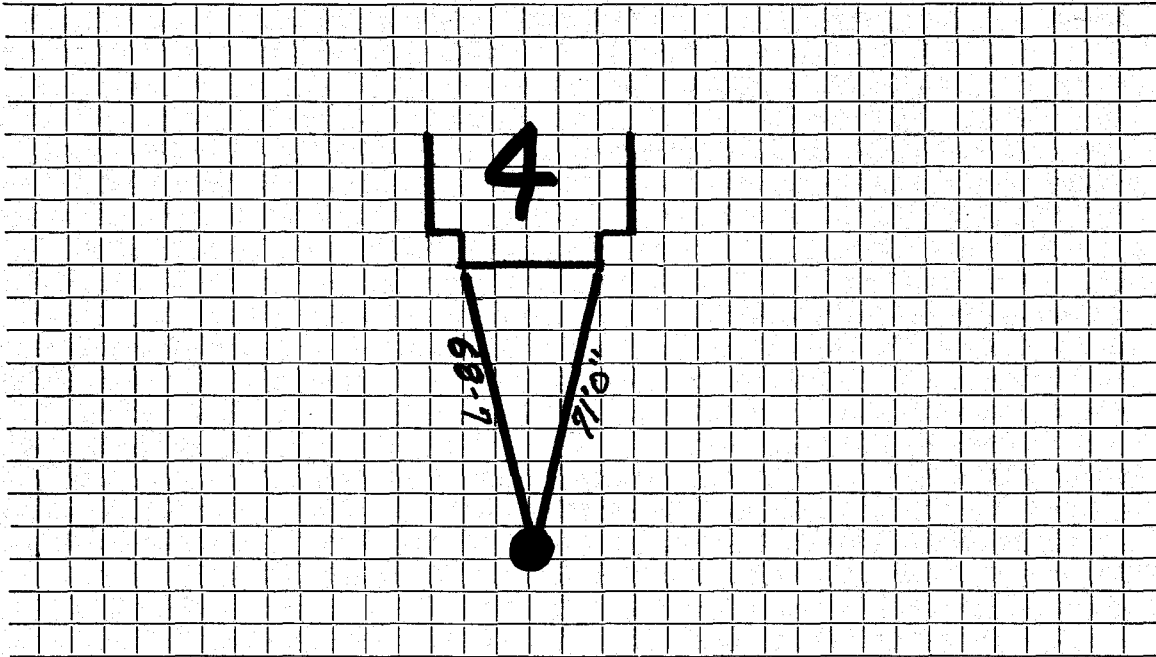

Connection made in Street. Work completed

Remarks:

.....

.....