

Name Miss Margaret Noyes

Service No. - 8 2665

Address 5 Tewksbury Street

Lexington, Mass.

Location 5 Tewksbury Street

Kind of Pipe

Size

Size of Main

~~Repair - Renewal - New Service~~

Location

Date	Material	Amount	Total	Date	Amount	
Aug. 9, '44	Labor		15 00	Oct. 17 '44	<i>Deposited</i> <i>Refunded</i> Non-Charge	30 00
	10% Overhead		1 50			9 46
	1 W. H. Stop & Waste		2 53			20 54
	2 Tail pieces @ .38		76			11 80
	Trucking 1 hr.		75			
			20.54	1 - $\frac{3}{4}$ " Copper Corp.		
				15' - $\frac{3}{4}$ " Copper Tubing		
				1 Curb box and shut off		
	Labor					

Hidley Press, Inc., Lexington

DATE _____

TOWN OF LEXINGTON—BOARD OF PUBLIC WORKS

WATER DIVISION

The undersigned applies for a supply of water at No. _____ St. and hereby agrees to comply with the rules and regulations as now, or at any future time, established by the Board of Selectmen.


Am't. of Estimate \$ _____

Owner _____

Am't. Paid \$ _____

Address _____

Builder _____

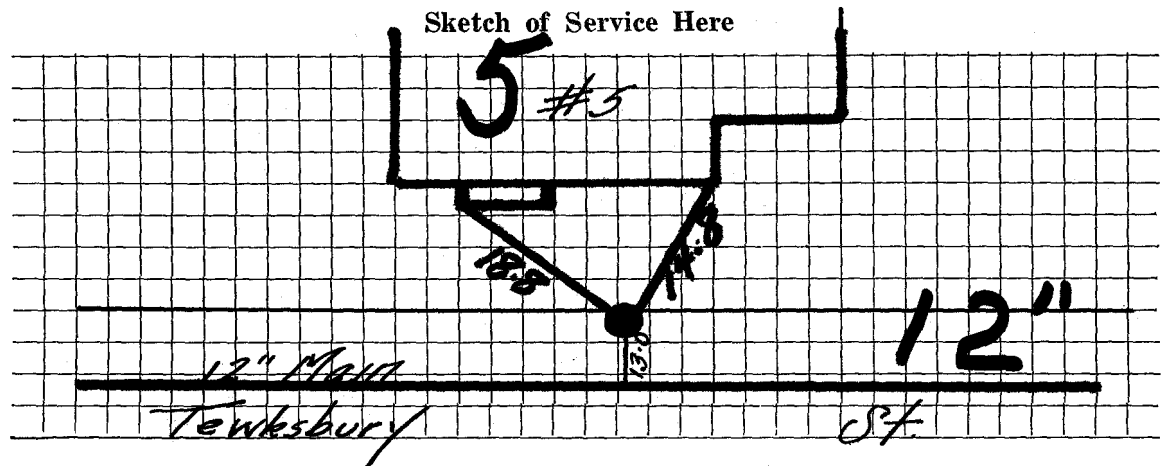

Connection made in _____ Street.

Work completed _____ 19

Remarks: