

Name

Service No. 2667

Address

Location

7 Tewkesbury St.

Kind of Pipe

Size

Size of Main

Repair—Renewal—New Service

Location

Date

Material

Amount

Total

Date

Amount

Labor

DATE _____

TOWN OF LEXINGTON—BOARD OF PUBLIC WORKS

WATER DIVISION

The undersigned applies for a supply of water at No. _____ St. and hereby agrees to comply with the rules and regulations as now, or at any future time, established by the Board of Selectmen.

Am't. of Estimate \$ _____

Owner


Michael Duffy

Am't. Paid \$ _____

Address

7 Tewksbury St.

Builder _____

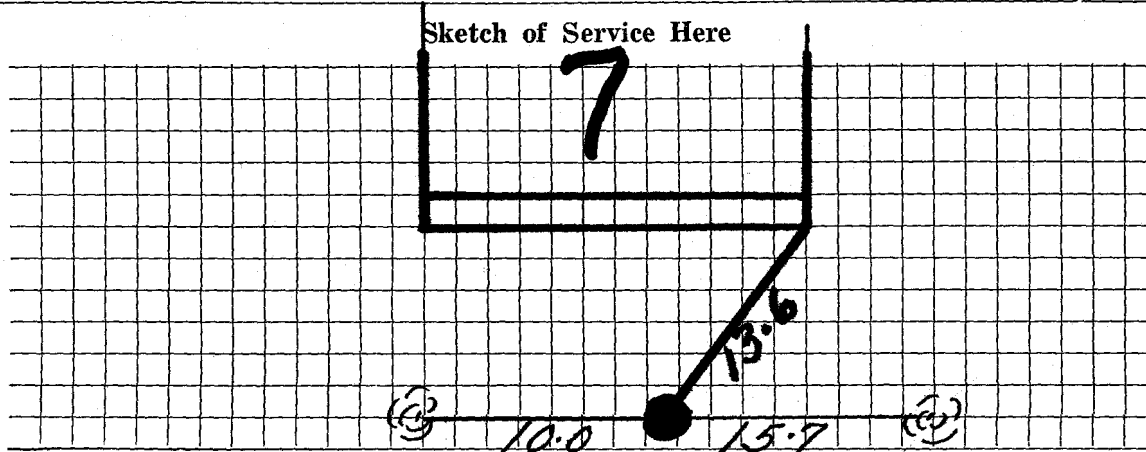

Connection made in _____ Street.

Work completed _____ 19

Remarks: