

Name

Service No. 2671

Address

17 Theresa Ave

#6352

Location

17 Theresa Ave.

Kind of Pipe

Size

Size of Main

Repair—Renewal—New Service

Location

Date

Material

Amount

Total

Date

Amount

48-97

Outside
 13.6 3/4 Copper
 1-3/4 Corp Adapt.
 1-1x3/4 Cop-Iron
 1-3/4 Curb
 1-Box

Labor

DATE _____

TOWN OF LEXINGTON—BOARD OF PUBLIC WORKS

WATER DIVISION

The undersigned applies for a supply of water at No. _____ St. and hereby agrees to comply with the rules and regulations as now, or at any future time, established by the Board of Selectmen.

Am't. of Estimate \$ _____

Owner

J. A. Murray


Am't. Paid \$ _____

Address

17. Theresane

Builder _____

Sketch of Service Here

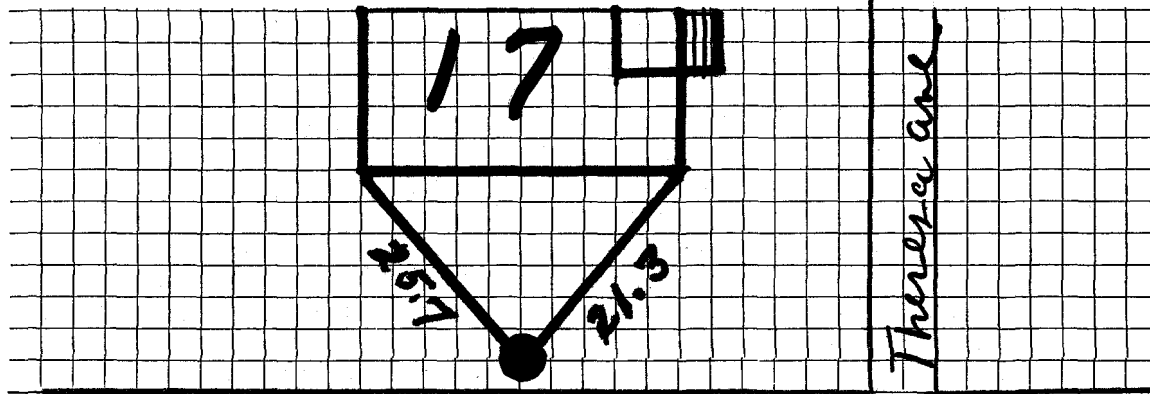

Connection made in _____

cliffe Street ane

Work completed _____

19

Remarks: