


DATE _____

TOWN OF LEXINGTON — BOARD OF PUBLIC WORKS

WATER DIVISION

Sketch of Service Here

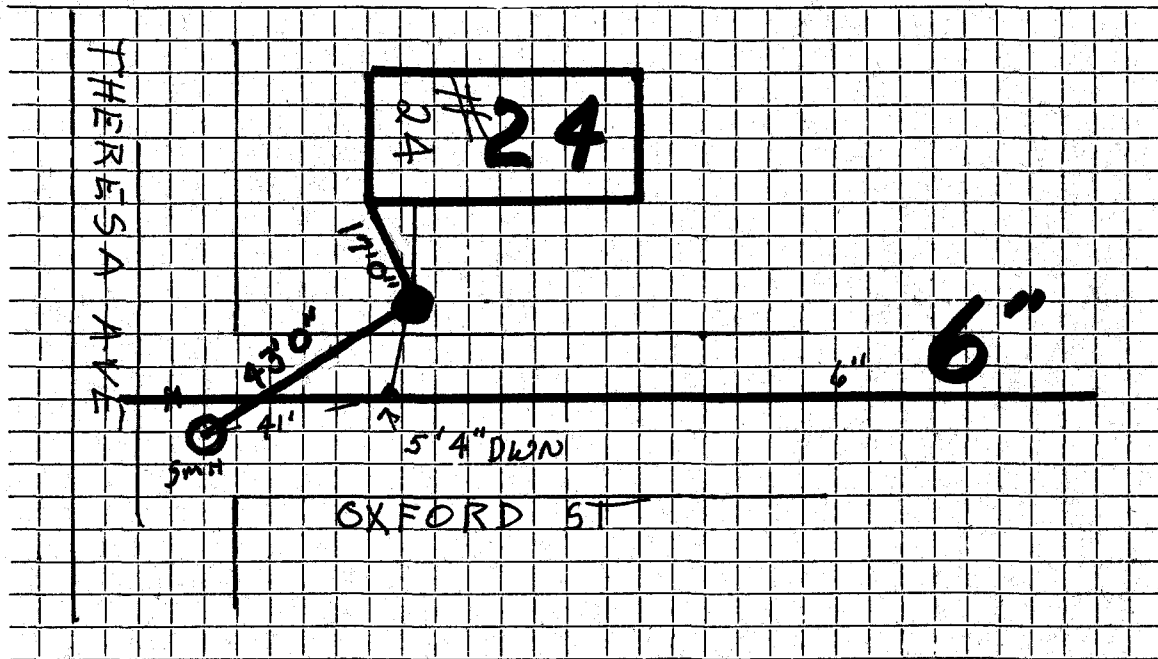

Connection made in OXFORD ST Street. Work completed 3/28/96

Remarks:

.....

.....