

WATER SERVICE RECORD

6166
8819

Name

Service No.

Address 25 Theresa Avenue

Location

~~Repair~~ Renewal ~~New Service~~ CRESCENT Plumbing


Date	Material	Amount	Total	Date	Amount
11/2/00 24'	1" Copper 1"x1" Comp. Buff to Box				
					NON CHARGE
				5-12-59	Labor 4 28
					11" 3/4" Copper Tubing @ 3.66 4 03
					1 3/4" C Curb Cock 6 03
					1 3/4" Adapter 1 95
					1 1" Style 38 Repair Clamp 2 14
					1 1"x3/4" Bushing 59
					1 1" Coupling 54
					1 Hr. Trucking @ .75 75
					20 65

DATE _____

TOWN OF LEXINGTON — BOARD OF PUBLIC WORKS

WATER DIVISION

Sketch of Service Here

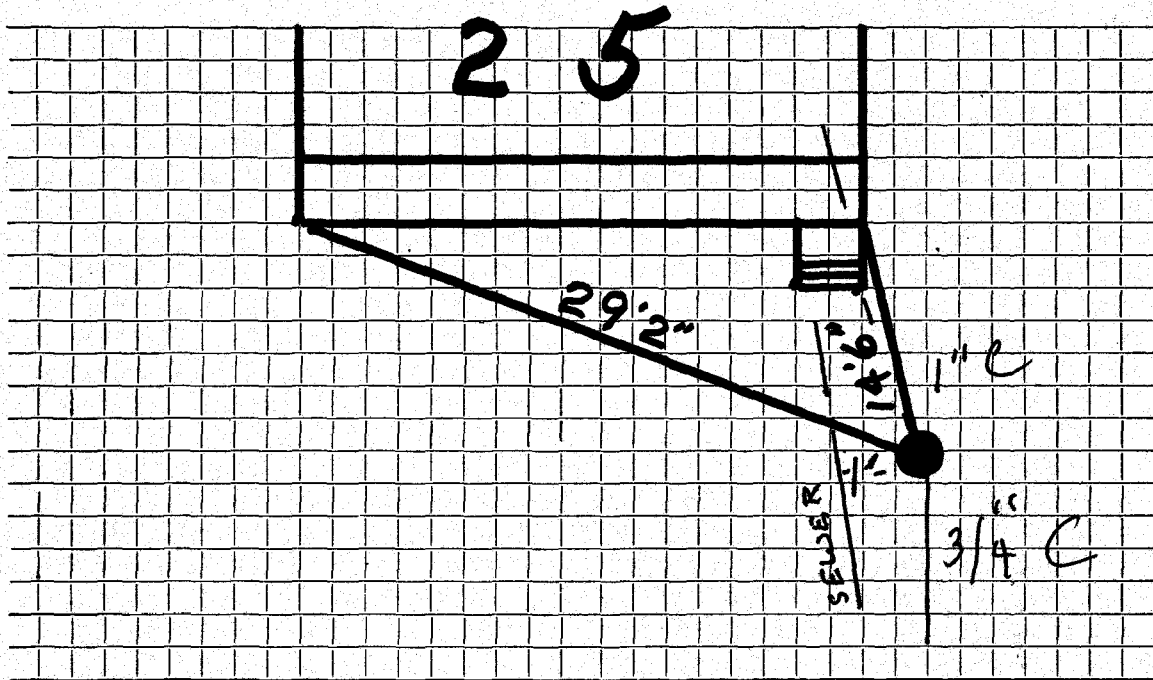

Connection made in Street. Work completed

Remarks: SERVICE PULLED — SEWER BESIDE WATER SAME DEPTH AT CURB TO PORCH.....