

## WATER SERVICE RECORD

Name

Service No.

Address 28 Theresa Avenue

Location

~~Repair—Renewal—New Service~~ W.O.#1383. (outside)


Date	Material	Amount	Total	Date	Amount
8-18-73	Labor	\$ 17.60			
10-3-73	"	133.16			
10-19-73	"	9.92	\$160.78		
	12' 3/4" Copper Pipe @.60		7.20		
	1 3/4" Curb Stop				
	1 3/4 3 Part Union				
	1 1" Repair Clamp				
	1 1" lead coupling				
	1 1" x 4" C.L. Nipple				
	1 1/2 Leads Gravel				
	1 Patch 9' x 9'				
	3 1/2 Hrs. Trucking				
	3 Hrs. Town Shovel				
	1/2 Hr. Loader				
	1/2 Hr. Pickup				
	1/2 Hr. Compressor				
	1 Hr. Roller				

DATE \_\_\_\_\_

TOWN OF LEXINGTON — BOARD OF PUBLIC WORKS

WATER DIVISION

Sketch of Service Here

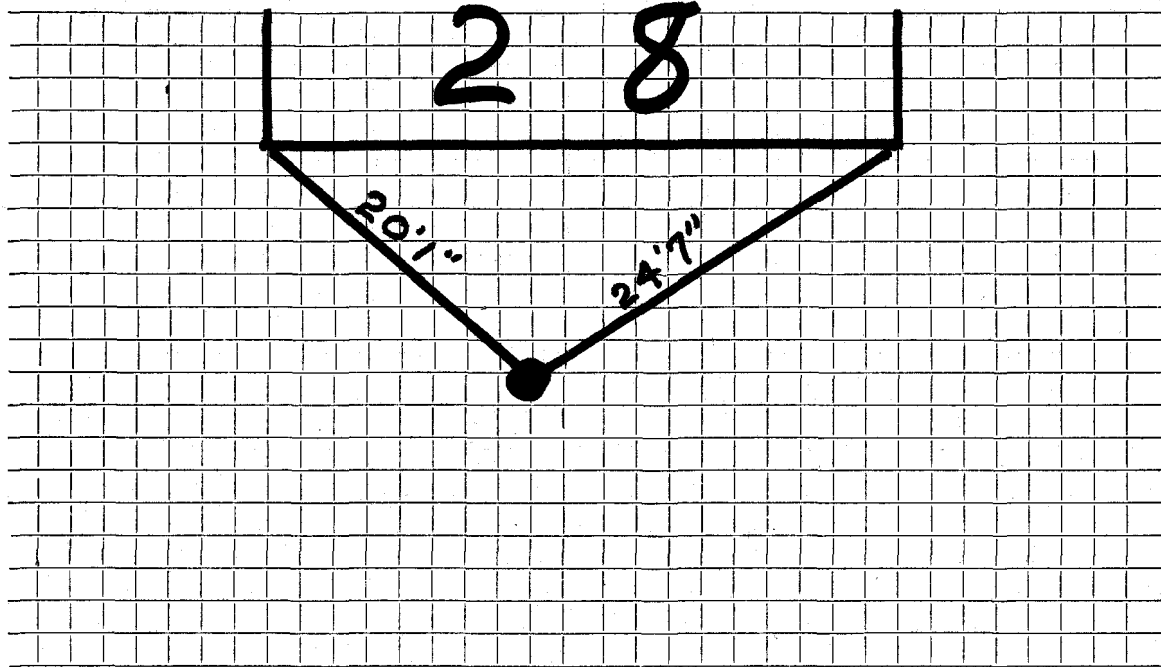

Connection made in ..... Street. Work completed .....

Remarks: .....  
.....  
.....