

WATER SERVICE RECORD

Name

Service No.

Address

7 Theresa Avenue

7435, 7436

Location

~~Repairs Renewals New Service~~

Renewals


Date	Material	Amount	Total	Date	Amount
3-11-29					
	23' 1" C.L. Pipe				
	2 1" L.H. ELLs				
	2 1" Br. Sp. Nipples				
	1 1" L.H. Coupling			5-11-59	
	1 Stop + Waste				
					NON CHARGE
					Labor
					2 14
					15' 3/4" Copper Tubing @ 3666
					5 50
					1 3/4" Adaptor
					1 95
					1 3/4" Curb Cock
					6 03
					1 1" Lead Lined Coupling
					54
					1 1"x5" GL Nipple
					34
					1 1" Style 38 Repair Clamp
					2 14
					1 Hour Trucking @ 75
					75
					<u>19 59</u>

DATE _____

TOWN OF LEXINGTON — BOARD OF PUBLIC WORKS

WATER DIVISION

Sketch of Service Here

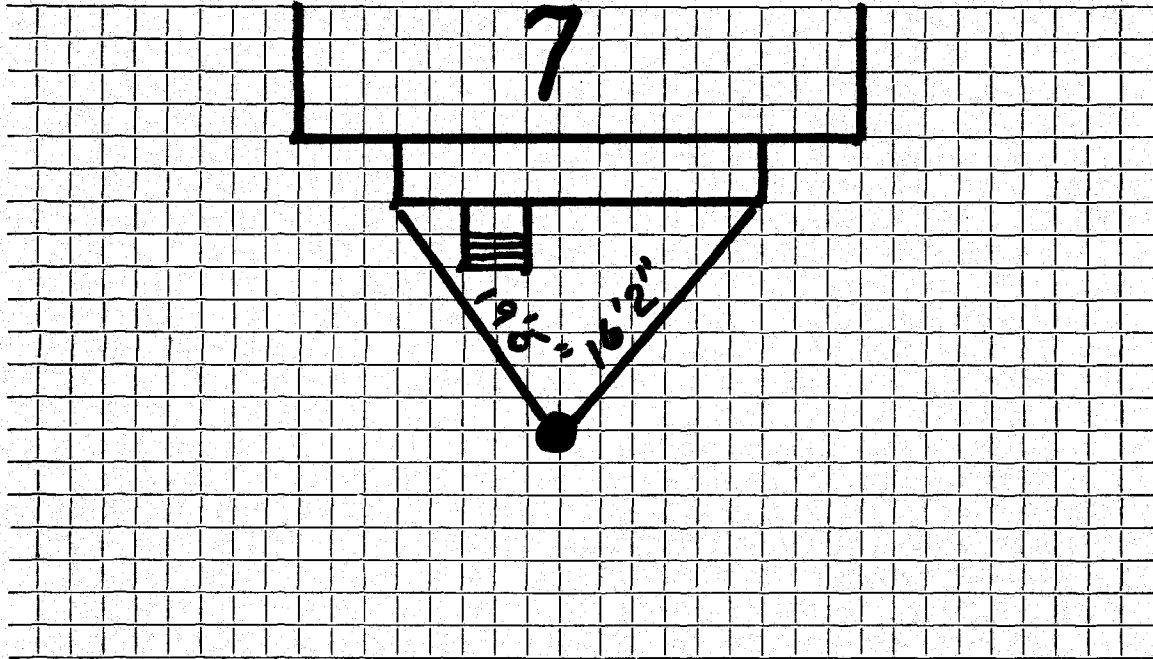

Connection made in Street. Work completed

Remarks:

.....

.....