

WATER SERVICE RECORD

Name Ralph Frissore

Service No. 96

Address 3 Third Street

Location

~~Repair~~ ~~Renewal~~ ~~New Service~~


Comm. 9/30/57

Date	Material	Amount	Total	Date	Amount
9/19/57	Labor	28 62		5-21-57 Deposit	\$ 75 00
	10% overhead	2 86	31 48	9-30-57 Refund	6 76
	45' - 3/4" Copper tubing @ .4228	19 03		NON CHARGE	\$ 68 24
	1 - 3/4" Cx 1/2 I.W.H. Stop & Waste	4 96	4 96	Labor	13 42
	1 hr. Trucking		75	21' - 3/4" Copper tubing @ .4228	8 88
	1 1/2 hrs. Town Shovel @ 6.50		9 75	1 - 3/4" C. Corp Cock	4 64
	1 - 3/4" C Union (3 part)		2 27	1 - 3/4" C. Curb Cock	5 94
			68 24	1 Box & Rod	4 62
				1 - 1/2 Straight tailpiece	50
				1 - 1/2 Offset tailpiec	50
				1/2 hr. Town Shovel @ 6.50	3 25
					41 75

DATE _____

TOWN OF LEXINGTON — BOARD OF PUBLIC WORKS
WATER DIVISION

Sketch of Service Here

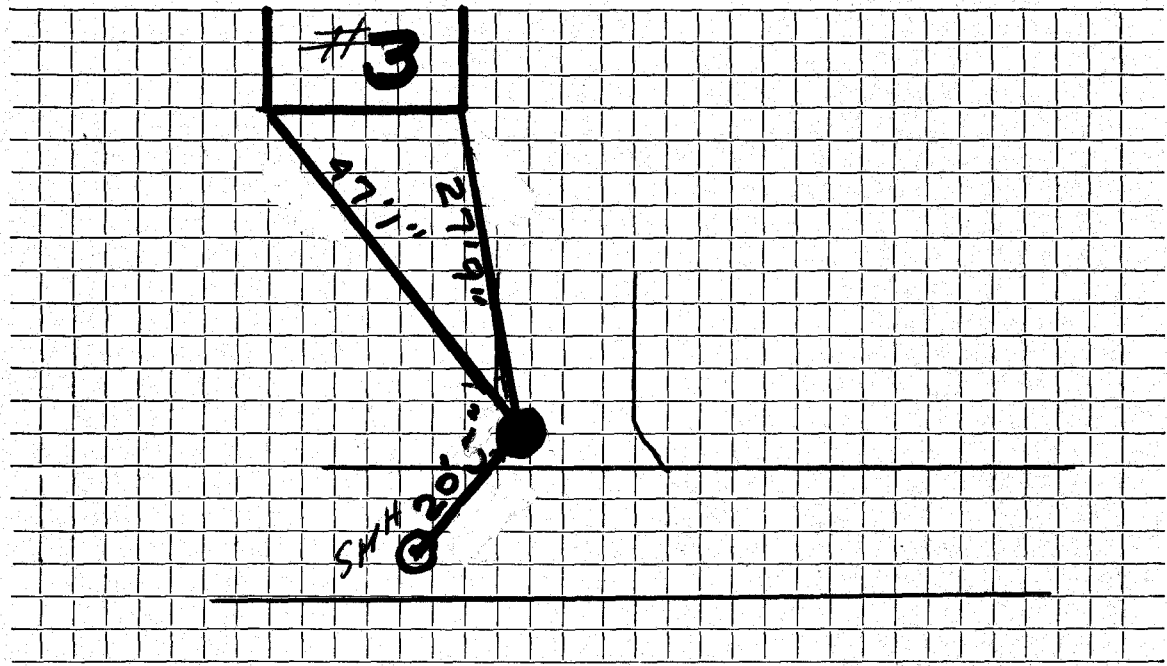

Connection made in Street. Work completed

Remarks:
.....
.....