

WATER SERVICE RECORD

Name **Brendan Walsh**

Service No. 52

(76)

Address **6 Third Street**

Location

~~Revised Receipt~~ New Service W.O. #4505 D Devine #2824

MAR 15 1976


Date	Material	Amount	Total	Date	Amount
12/9/75	Labor	41.46		11-21-75	1000.00
12/12/76	"	63.90	105.36	3-15-76	544.35
	10% O.H.	10.54	115.90		425.41
78'	1" Copper tubing @1.30		101.40		
1	1" Corp		16.69		
1	1" Curb Box		15.40		
1	1" Curb Stop		18.67		
1½	ton Cold Patch		20.55		
	7' x 25' Patch		108.00		
3	hrs. Trucking @3.00		9.00		
1	hr. Compressor @4.00		4.00		
2	hrs. Town Shovel @6.50		13.00		
1	hr. Roller @3.00		3.00		
			425.61		
6/2/76	64' 1" Copper tubing				

DATE _____

TOWN OF LEXINGTON — BOARD OF PUBLIC WORKS

WATER DIVISION

Sketch of Service Here

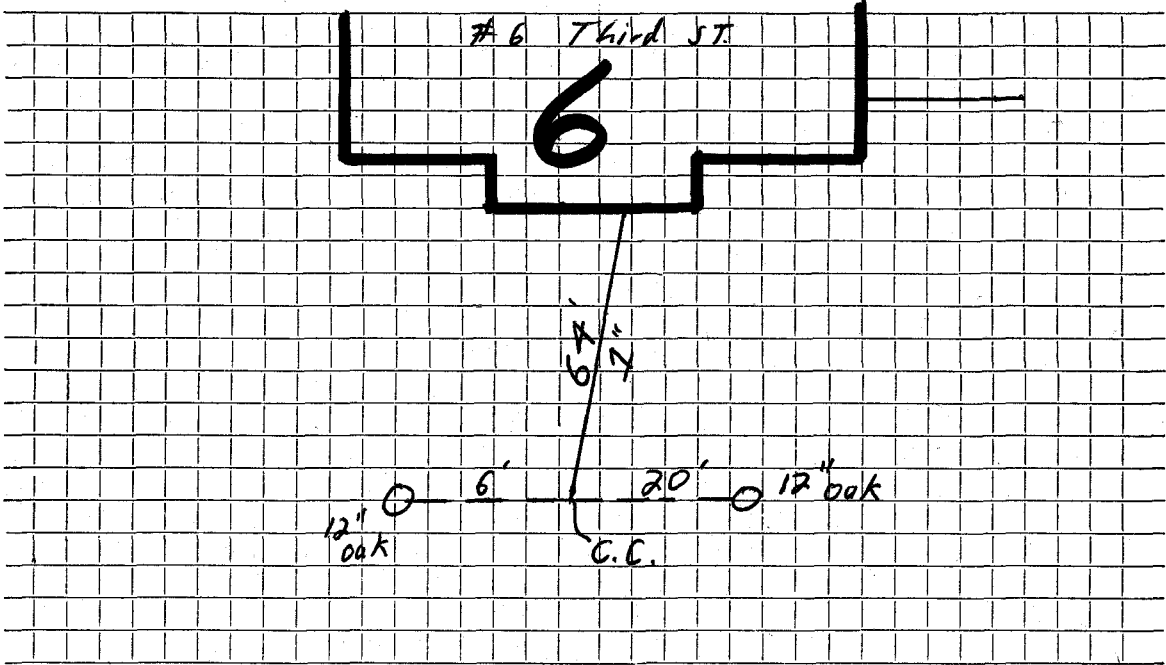

Connection made in Street. Work completed

Remarks:
.....
.....