

WATER SERVICE RECORD

3304

Name Richard Magnanti

Service No. 95

Address 10 Thoreau Road

Location Lot #32

~~Repair - Repair~~ - New Service

Comm 7-6-59


Date	Material	Amount	Total	Date	Amount
5-22-59	Labor	2 36		5-18-59	100 00
	10% O. H.	24	2 60	7-6-59	76 61
	55' 3/4" Copper Tubing @.3666		20 16		29 59
	1 3/4" C x 1/2 IWH Stop & Waste		5 88		NON CHARGE
	1 Hr. Trucking @.75		75	10-17-58	Labor 8.78
			29 39		31' 3/4" Copper tubing @.37 11.47
					1 3/4" C Corp Cock 4.64
					1 3/4" C Curb Cock 6.03
					1 Box & Rod 5.00
					35.92
				5-22-59	1 1/2 Straight Tailpiece 50
					1 1/2 Offset Tailpiece 50
					36 92

DATE _____

TOWN OF LEXINGTON — BOARD OF PUBLIC WORKS

WATER DIVISION

Sketch of Service Here

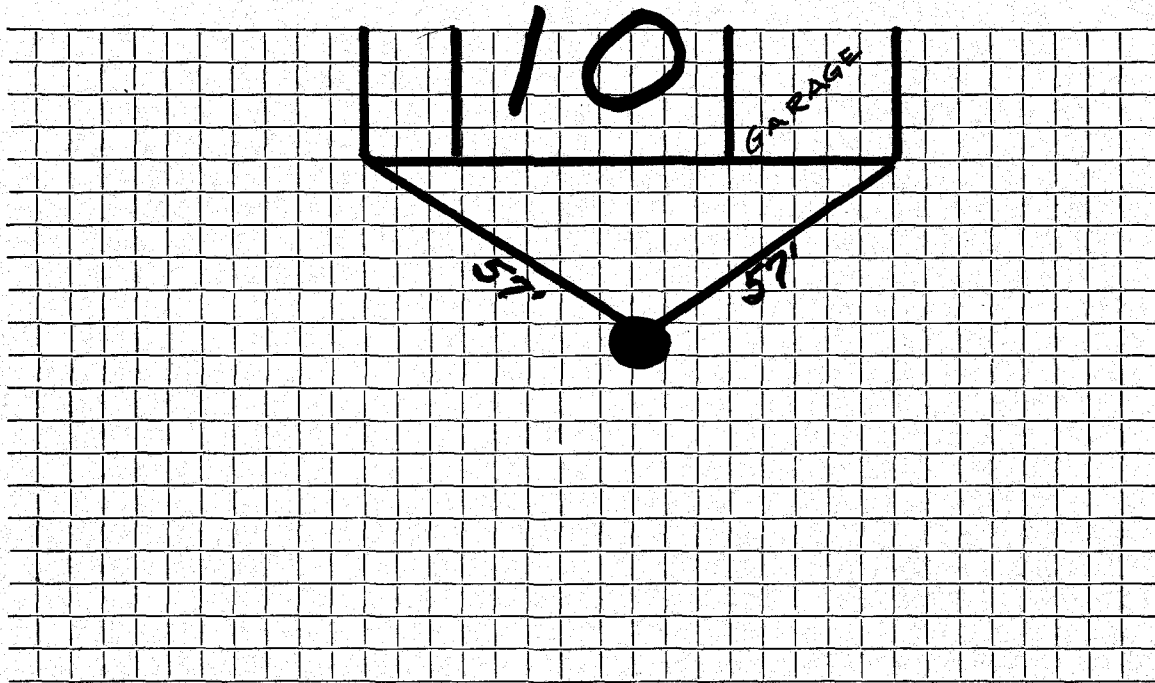

Connection made in *T. HAIZEAU RD.* Street.

Work completed

Remarks:
.....
.....