

WATER SERVICE RECORD

Name Moore Realty Trust

Service No. 80

Address 12 Thoreau Road

Location Lot #33

~~XXXXXX~~ New Service

Comd 74-59


Date	Material	Amount	Total	Date	Material	Amount
5-27-59	Labor	3 54		4-30-59	Deposit	50 00
	10% O. H.	35	3 89	7-6-59	Retard	13 35
65'	3/4" Copper Tubing @.3666		23 83			36 65
1	3/4" C x 1/2 IWH Stop & Waste		5 88		NON CHARGE	
1	3/4" C 3 part Union		2 30	10-17-58	Labor	7.64
1	Hr. Trucking		75	27'	3/4" Copper tubing @.37	9.99
			36 65	1	3/4" C Corp Cock	4.64
				1	Box & Rod	5.00
				1	3/4" C Curb Cock	6.03
						33.30
				5-22-59	1 1/2 Straight Tailpiece	50
					1 1/2 Offset Tailpiece	50
						34 30

DATE 3/8/59

TOWN OF LEXINGTON — BOARD OF PUBLIC WORKS

WATER DIVISION

Sketch of Service Here

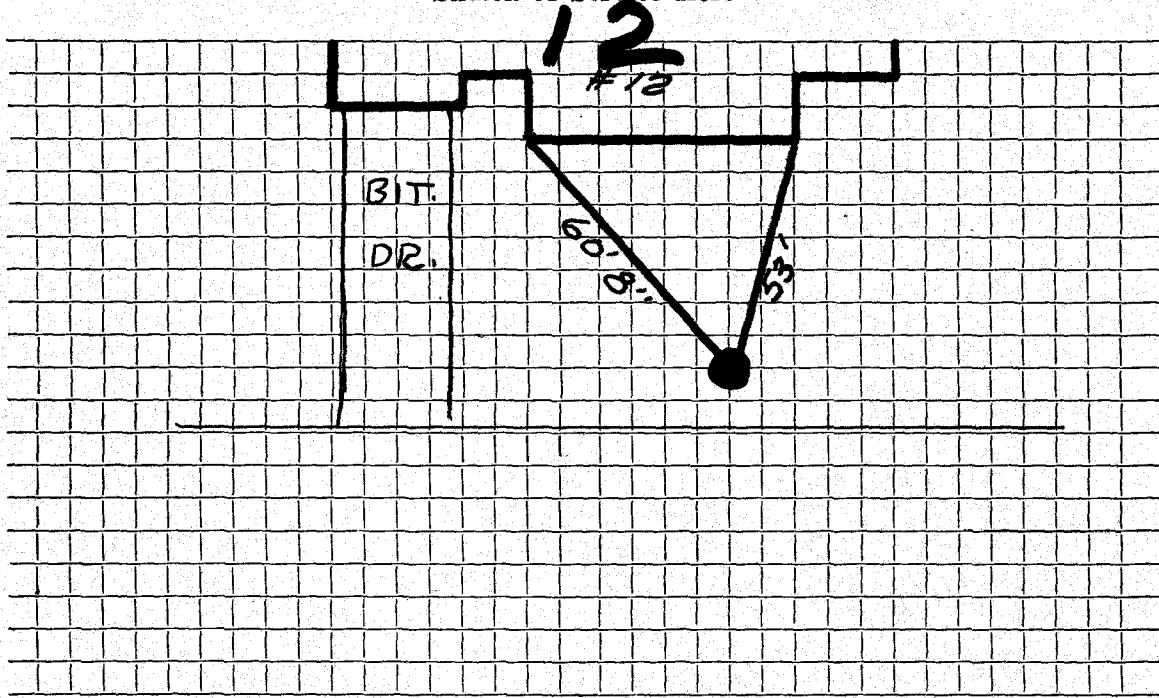

Connection made in THOREAU RD. Street.

Work completed

Remarks:

.....

.....