

WATER SERVICE RECORD

Name Richard Magnanti

Service No. 290

Address 17 Thoreau Road

Location

~~Repair~~ ~~Replacement~~ New Service

Com 12-31-59

Date	Material	Amount	Total	Date		Amount
11-4-59	Labor	11.80		11-3-59	Deposit	50 00
	10% O.H.	1.18	12.98	1-29-60	Paid	11 95
90'	3/4" Copper tubing @.42		37.80			61 95
1	3/4" C x 1/2 I.W.H. Stop & Waste	5.88			<u>NON CHARGE</u>	
2	3/4"C 3 part union @ 2.27	4.54	4.54	7-29-59	Labor	2 04
1	hr. Trucking @.75	.75	.75		7' 3/4" Copper tubing @.38	2 68
			61.95		1 3/4" C Corp Cock	4 67
					1 3/4" C Curb Cock	6 07
					1 Box & Rod	5 00
					1 Hr. Trucking	75
						21 19
					1 1/2 Straight tailpiece	.50
					1 1/2 Offset tailpiece	.50
						22.19


Bill sent 12-31-59

11.25

TOWN OF LEXINGTON — BOARD OF PUBLIC WORKS

WATER DIVISION

Sketch of Service Here
#17 THOREAU RD

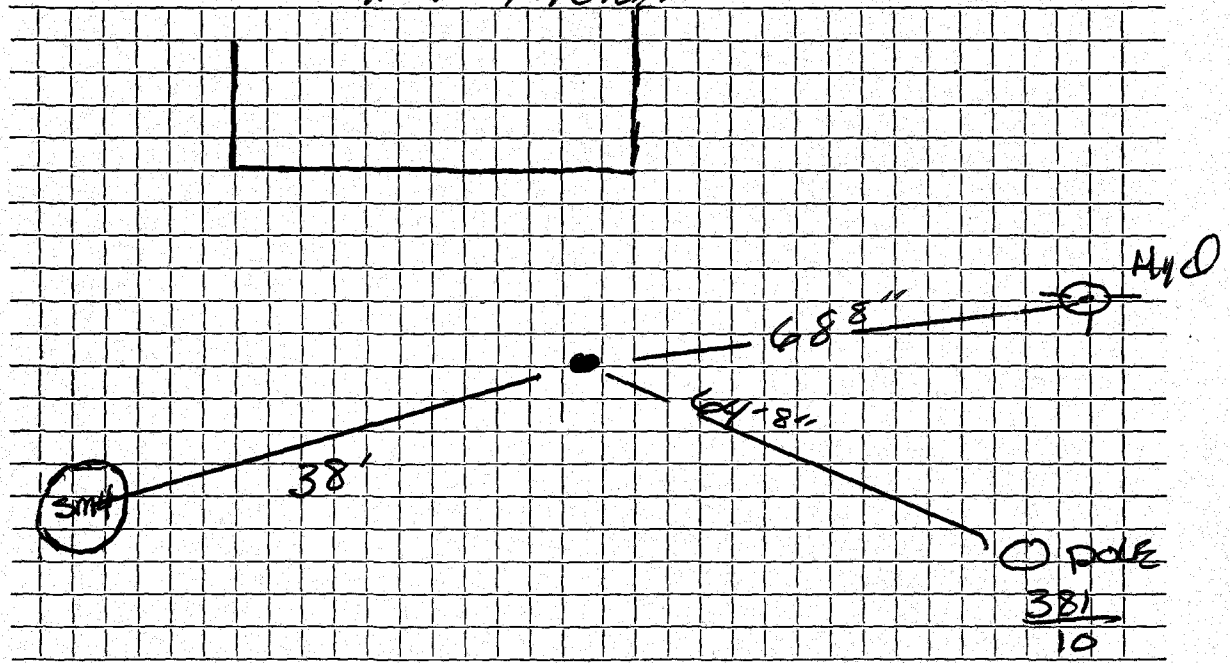

Connection made in Street. Work completed

Remarks: .. Curb is 8" UNDER DRIVEWAY

.....
.....