

WATER SERVICE RECORD

# 3554

Name John Moore

Service No. 45

Address 2 Thoreau Road

Location Lot #20

~~Repair~~ ~~Renewal~~ New Service


Comm 5-4-59

Date	Material	Amount	Total	Date	Material	Amount
<del>4-14-59</del>	Labor	3 62		4-14-59	Deposit P	50 00
	10% O. H.	36	3 98	5-4-59	Retained	11 50
70'	3/4" Copper Tubing @.3666	25 66				38 50
1	3/4" C x 1/2 I.W.H. Stop & Waste	5 84			NON CHARGE	
1	3/4" C 3 part Union	2 27		10-17-58	Labor	8.78
1	Hr. Trucking @.75		75	31'	3/4" Copper tubing@.37	11.47
			38 50	1	3/4" C Corp. Cock	4.64
				1	3/4" C Curb Cock	6.03
				1	Box & Rod	5.00
						25.47
				1	1/2 Straight Tailpiece	50
				1	1/2 Offset Tailpiece	50
						26 47

DATE 3/8/59

TOWN OF LEXINGTON — BOARD OF PUBLIC WORKS  
WATER DIVISION

Sketch of Service Here

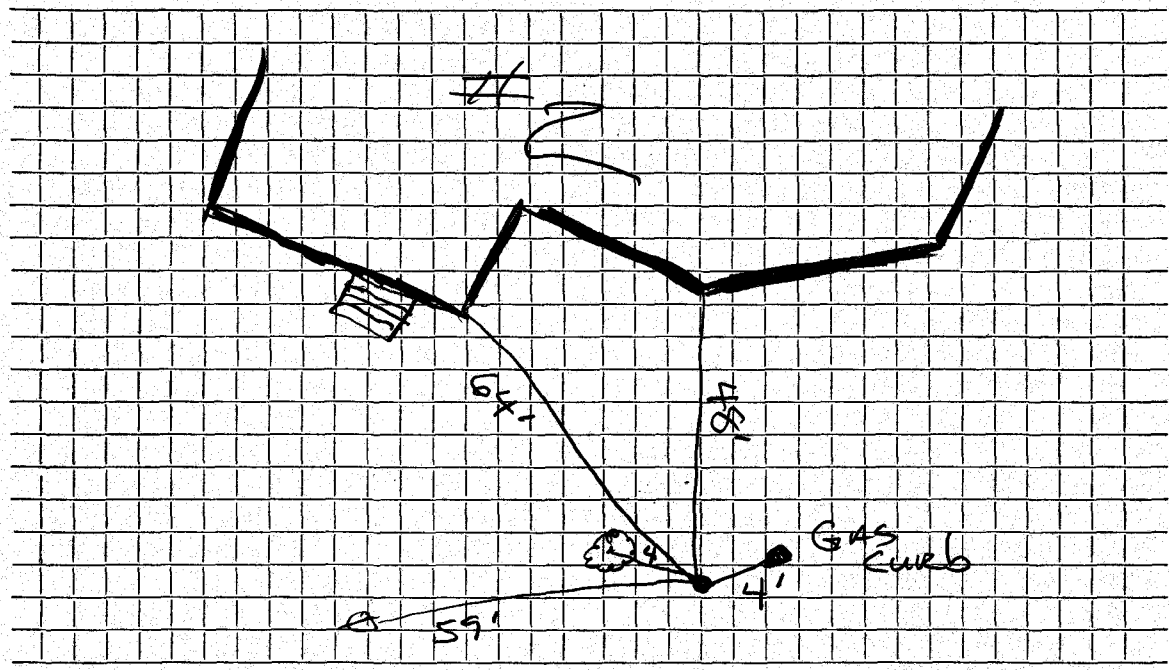

Connection made in E Street. Work completed .....

Remarks: .....  
.....  
.....