

WATER SERVICE RECORD

Name Robert Johnson

Service No. 3

Address 21 Thoreau Road

Location

~~Repair Renewal~~ New Service


WO # 7025

Comm 2-26-62

| Date    | Material                         | Amount | Total | Date    | Amount                       |
|---------|----------------------------------|--------|-------|---------|------------------------------|
| 1-17-72 | Labor                            | 12.03  |       | 1-9-62  | Deposit 125.00               |
|         | 10% O.H.                         | 1.20   | 13.23 | 2-26-62 | Refund 64.09                 |
| 55'     | 3/4" Copper tubing @.42          |        | 23.10 |         | 60.91                        |
| 1       | 3/4" C x 1/2 I.W.H. Stop & Waste |        | 6.17  |         | <u>NON CHARGE</u>            |
| 1       | 3/4" C 3 part union              |        | 2.41  | 7-29-59 | Labor 2.04                   |
| 2       | hrs. Town Shovel @6.50           |        | 13.00 | 7'      | 3/4" Copper Tubing @.38 2.66 |
| 1       | hrs. Trucking @3.00              |        | 3.00  | 1       | 3/4" C Corp Cock 4.67        |
|         |                                  |        | 60.91 | 1       | 3/4" C Curb Cock 6.07        |
|         |                                  |        |       | 1       | Box & Rod 5.00               |
|         |                                  |        |       | 1       | Hr. Trucking 75              |
|         |                                  |        |       |         | <u>21.19</u>                 |
|         |                                  |        |       | 1       | 1/2 Straight tailpiece .50   |
|         |                                  |        |       | 1       | 1/2 Offset tailpiece .50     |
|         |                                  |        |       |         | <u>22.19</u>                 |

TOWN OF LEXINGTON — BOARD OF PUBLIC WORKS  
WATER DIVISION

Sketch of Service Here

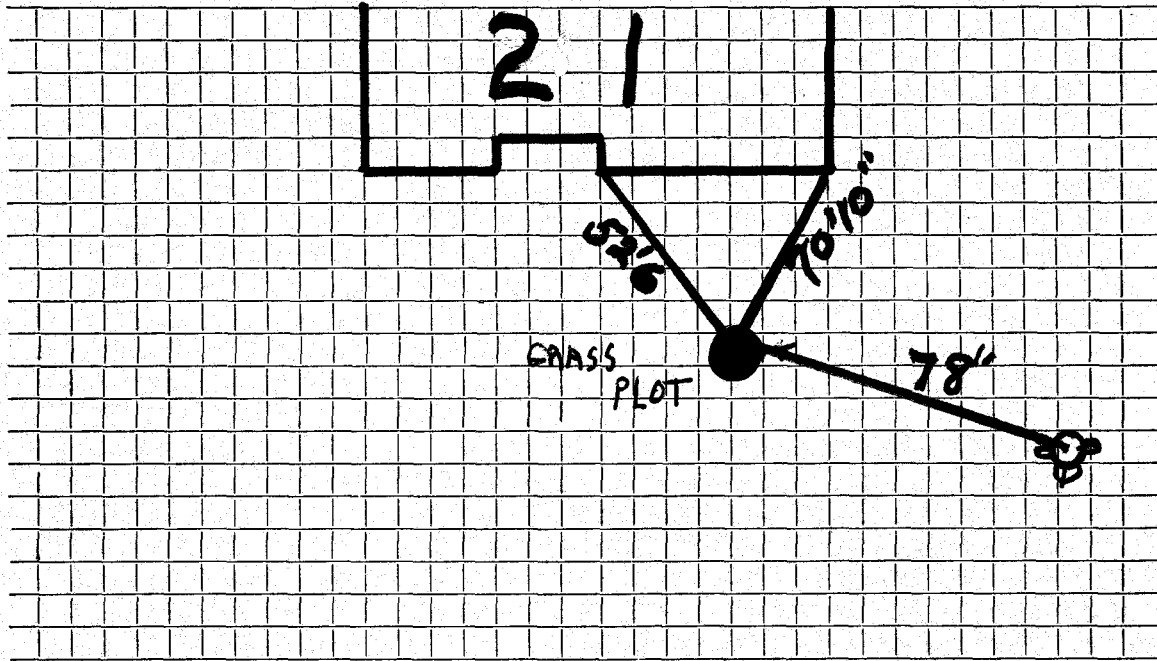

Connection made in ..... Street. Work completed .....

Remarks: .....

.....

.....