


DATE _____

TOWN OF LEXINGTON — BOARD OF PUBLIC WORKS
WATER DIVISION

Sketch of Service Here

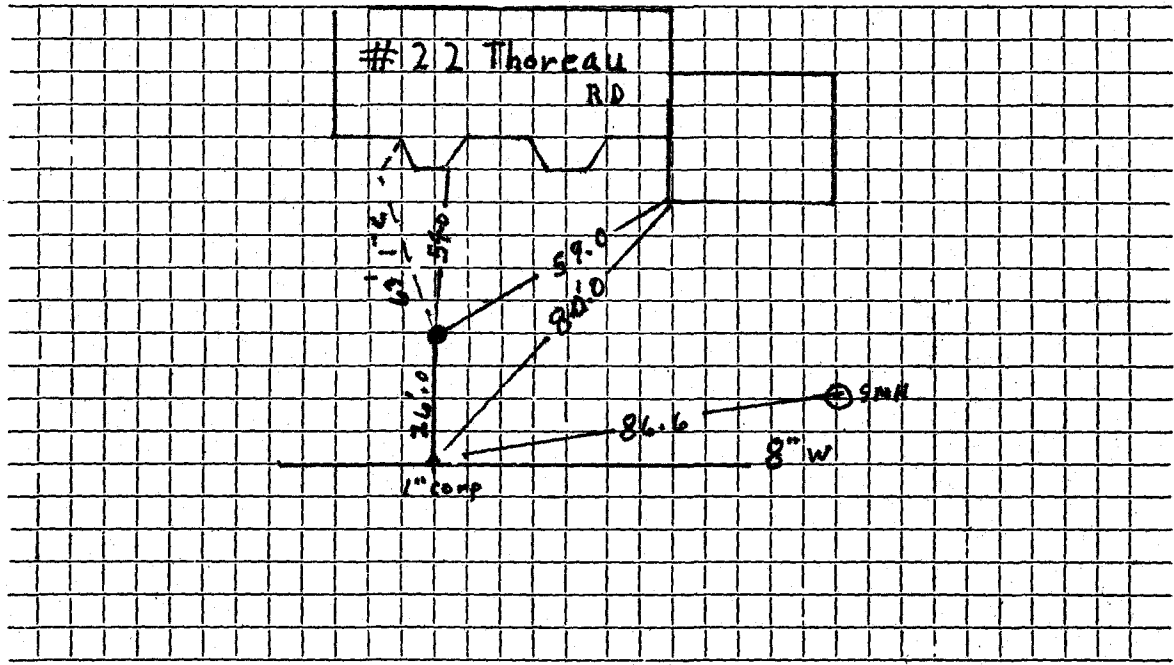

Connection made in Street. Work completed 10/9/02.....

Remarks: 3/4\" Sh. T. A. T. Corp......

.....
.....