

## WATER SERVICE RECORD

#4581

Name Emerson Realty Trust

Service No. 118

Address 26 Thoreau Road

Location

~~REPAIR - RENEWAL~~ - New Service

Comm 8-22-60


Date	Material	Amount	Total	Date	Amount
7-13-60	Labor	3 90		7-12-60	50 00
	10% U.H.	39	4 29	9-6-60	8 57
90'	3/4" Copper tubing @.42		37 80		58 57
1	3/4" Cx 1/2 I.W.H. Stop&Waste		6 17		<u>NON CHARGE</u>
1	3/4" C3 part Union		2 41	7-29-59	Labor
1	Box & Rod		4 90	20'	3/4" Copper Tubing @.38
1	Hr Trucking @3.00		3 00	1	3/4" C Corp Cock
			58 57	1	3/4" C Curb Cock
				1	Box & Rod
				1	Hr. Trucking
					<u>29 91</u>
				1	1/2 Straight tailpiece
				1	1/2 Offset tailpiece
					<u>50</u>
					30 91

Bill sent 8-22-60 8.57

DATE \_\_\_\_\_

**TOWN OF LEXINGTON — BOARD OF PUBLIC WORKS**  
**WATER DIVISION**

Sketch of Service Here

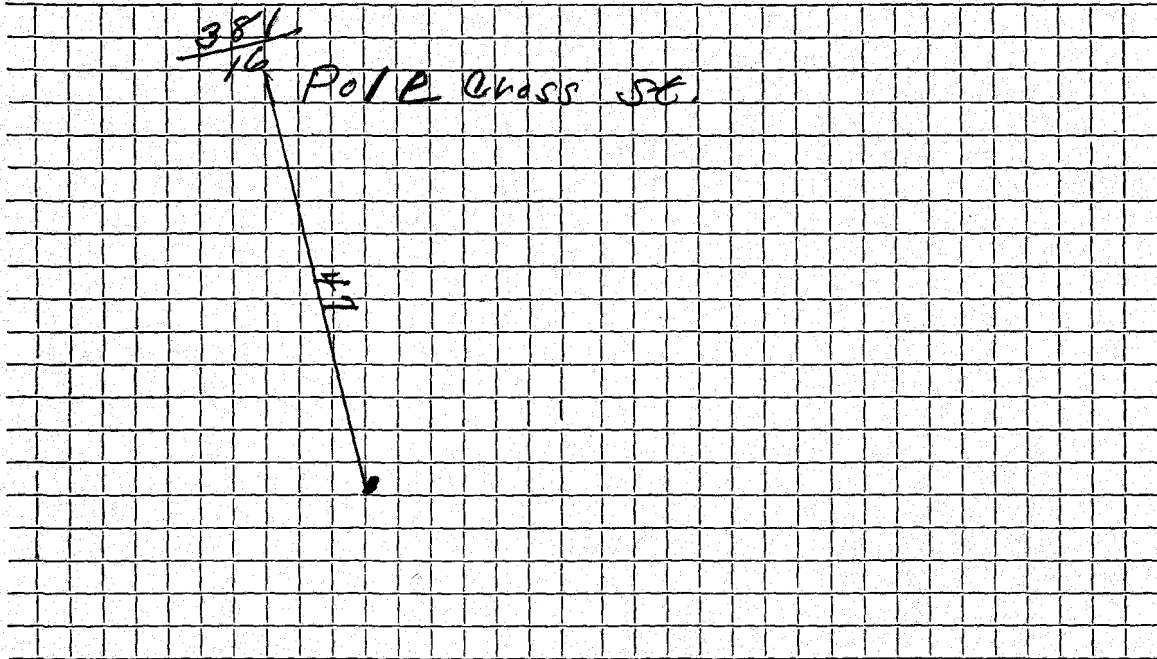

Connection made in ..... Street.      Work completed .....

Remarks: .....  
.....  
.....

**WATER SERVICE RECORD**

Name **Manning Stoller**

Service No. **21**

Address **26 Thoreau Road**

Location **1" Pit Meter**

~~REPAIR RENEWAL~~ **New Service W.O. #6480**

**SEP 25 1978**

Date	Material	Amount	Total	Date	Amount
7-31-78	Labor	152.67		7-31-78	400.00
	10% O.H.	15.27	167.94		
26'	1" Copper tubing @.90		23.40	8-15-78	46.14
1	1" Corp		17.86		
1	1" Curb		21.98		446.14
1	Box & Rod		11.00		
1	1" Stop & Waste		17.85		
2	1" Tailpieces @2.00		4.00		
2	1" x 6" Brass Nipples @3.00		6.00		
1	1" Coupling		.85		
1	1" x 90° Brass Elbow		3.26		
1	yd. Loam		5.44		
½	lb. Grass Seed		.37		
½	ton Cold Patch		7.37		
20	Barrel Blocks @.43		8.60		
1	Pit Meter Frame & Cover		27.60		
2	hrs. Backhoe @6.50		13.00		
1	hr. Trucking		3.00		
	Hot Top 8' x 20'		106.62		
			<u>446.14</u>		

DATE \_\_\_\_\_

TOWN OF LEXINGTON — BOARD OF PUBLIC WORKS

**WATER DIVISION**

Sketch of Service Here

A large rectangular area filled with a grid of small squares, intended for drawing a sketch of service.

Connection made in ..... Street.                      Work completed .....

Remarks: .....  
.....  
.....