


TOWN OF LEXINGTON — BOARD OF PUBLIC WORKS
WATER DIVISION

DATE 9/21

Sketch of Service Here

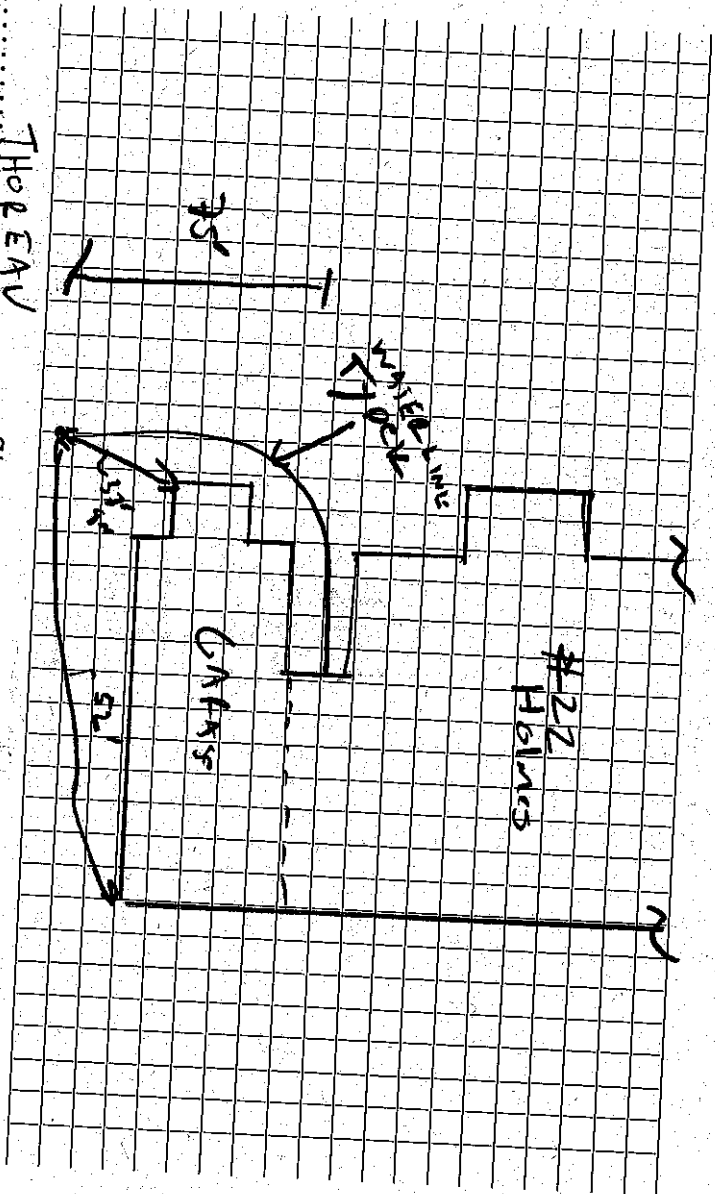

Connection made in.....**THORPEAV**..... Street.....
Remarks:.....
Work completed.....

WATER SERVICE RECORD

Name John Moore

Service No. 282

Address 3 Thoreau Road

Location Lot #38

~~Repair~~ ~~Renewal~~ New Service

Comm 5-4-59

Date	Material	Amount	Total	Date	Amount
4-1-59	Labor	1 77		12-15-58	Deposit 50 00
	10% O.H.	18	1 95	5-4-59	Refund 19 46
	60' 3/4" Copper Tubing @.3666		22 00		30 54
	1 3/4" C x 1/2 I.W.H. Stop & Waste	5 84			NON CHARGE
	1 Hr. Trucking @.75		75	10-17-58	Labor 3.96
			30 54		14' 3/4" Copper tubing @.37 5.18
					1 3/4" C Corp Cock 4.64
					1 3/4" C Curb Cock 6.03
					1 Box & Rod 5.00
					<u>24.81</u>
				4-1-59	1 1/2 Straight Tailpiece 50
					1 1/2 Offset Tailpiece 50
					<u>25 81</u>

DATE _____

TOWN OF LEXINGTON — BOARD OF PUBLIC WORKS

WATER DIVISION

Sketch of Service Here

A large grid of graph paper, consisting of 20 columns and 20 rows of small squares, intended for sketching service details.

Connection made in Street. Work completed

Remarks:

.....

.....