


DATE _____

TOWN OF LEXINGTON — BOARD OF PUBLIC WORKS

WATER DIVISION

Sketch of Service Here

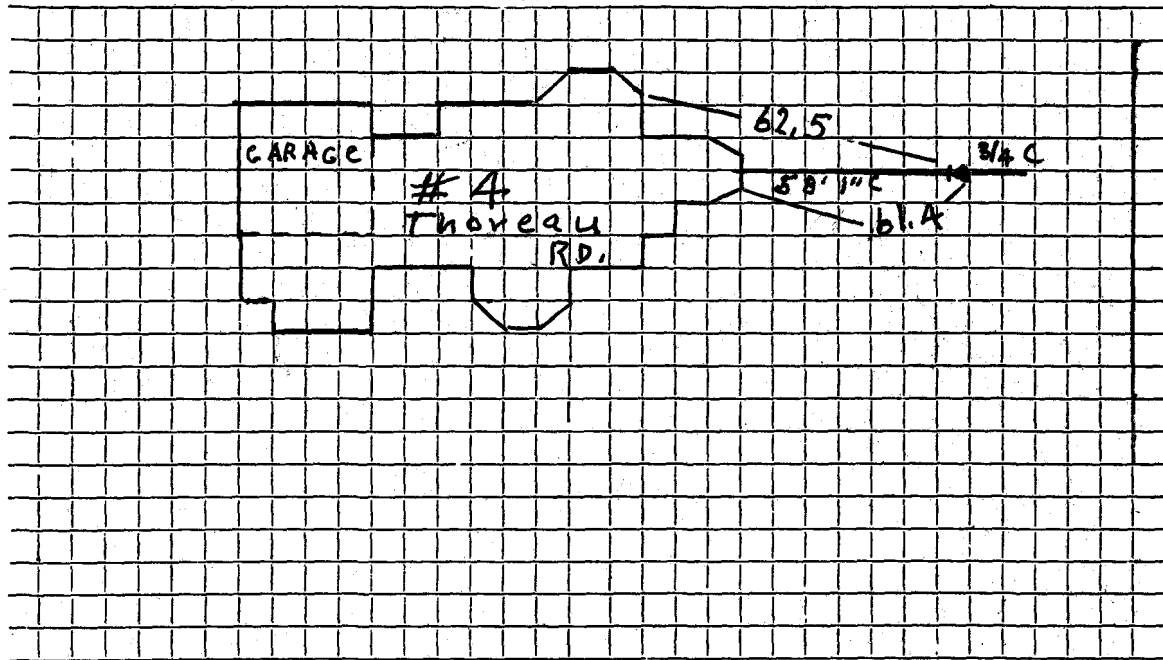

Thoreau RD

Connection made in Thoreau RD Street. Work completed April 2004

Remarks: