


Water Service Tie Card
TOWN OF LEXINGTON

5 Thoreau Rd

MASSACHUSETTS

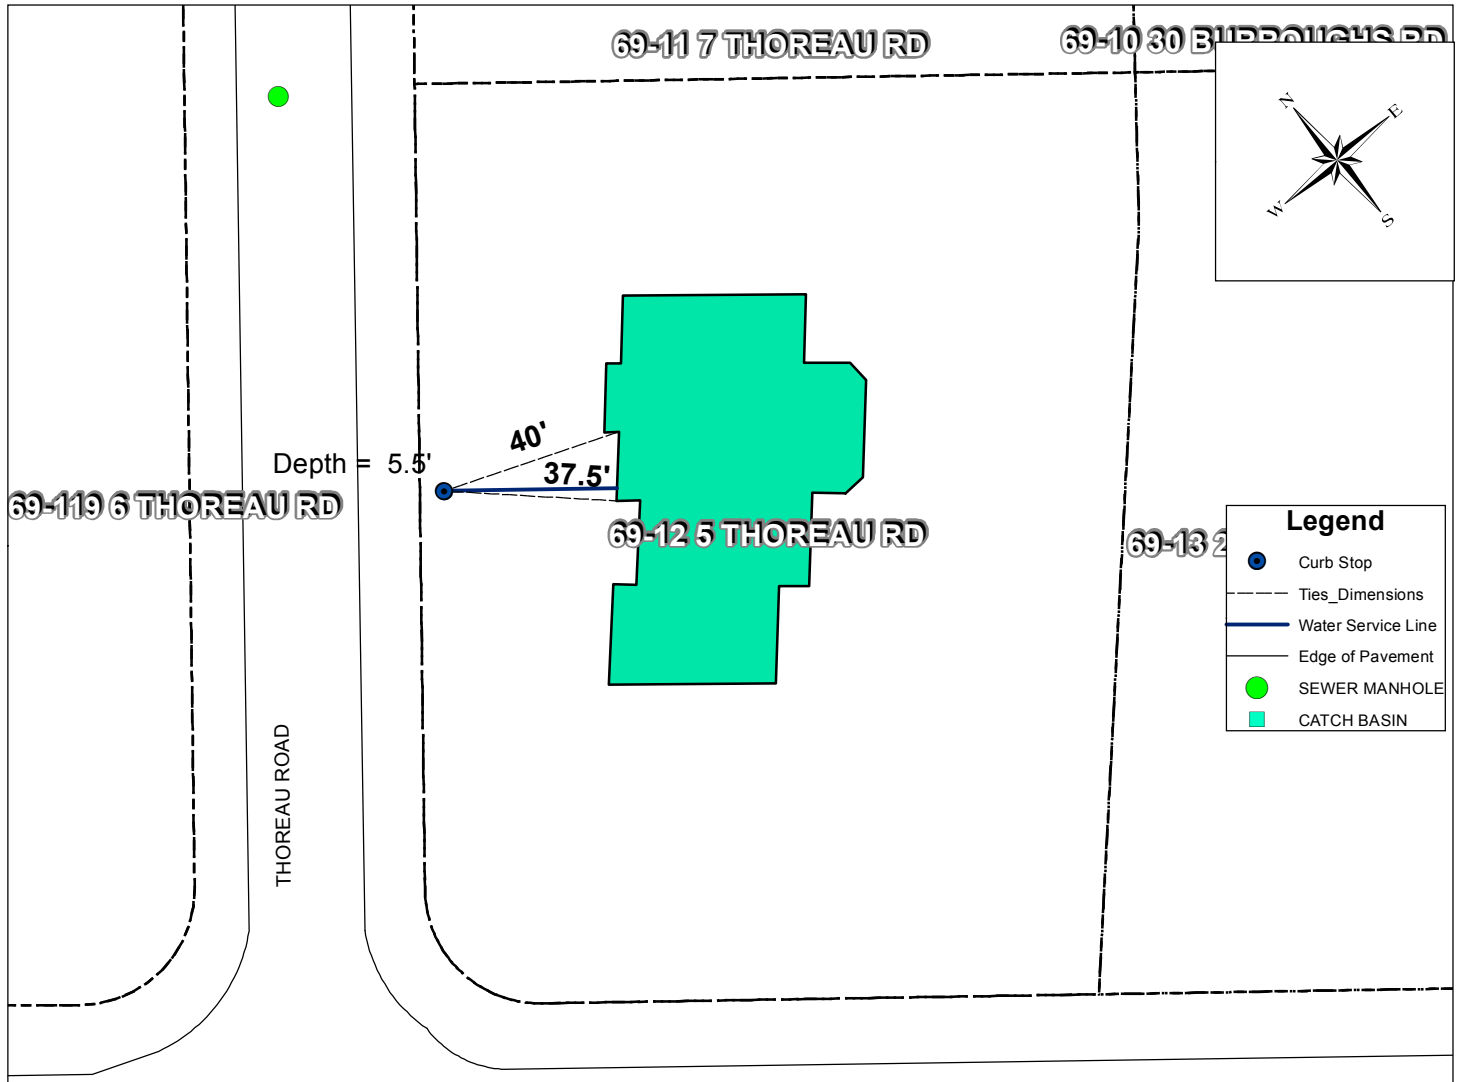

Address	Map and Lot	Permit Number	Contractor Name	Inspector
5 Thoreau Rd	69-12	6071	S&T Frotton, Inc.	msprague
Date	Material	Depth of Cover	Amount	
4/17/2015	3/4" copper type "k"		2 ft	
	1" Curb Valve and Buffalo Box	5.5 ft	1	
	1" Copper type "k"	7 ft	39 ft to HSE	
Type of work completed				

New 1" water service to house from curb stop. New house on lot old house removed.