

WATER SERVICE RECORD

Name Louis Stoico Inc.

Service No. 73

Address 6 Thoreau Road

Location Lot #30

~~Repair~~ ~~Renewal~~ New Service

Comm 6-22-59


Date	Material	Amount	Total	Date		Amount
5-5-59	Labor	3.62		4-23-59	Deposit	50.00
	10% O.H.	.36	3.98	6-22-59	Retard	11.50
70'	3/4" Copper tubing @.3666		25.66			38.50
1	3/4" C x 1/2 I.W.H. Stop & Waste		5.84		NON CHARGE	
1	3/4" C 3 part union		2.27	10-17-58	Labor	8.78
1	hr. Trucking @.75		.75	31'	3/4" Copper tubing @.37	11.47
			38.50	1	3/4" C Corp Cock	4.64
				1	3/4" C Curb Cock	6.03
				1	Box & Rod	5.00
						35.92
				1	1/2 Straight tailpiece	.50
				1	1/2 Offset tailpiece	.50
						36.92

DATE 3/8/59

TOWN OF LEXINGTON — BOARD OF PUBLIC WORKS

WATER DIVISION

Sketch of Service Here

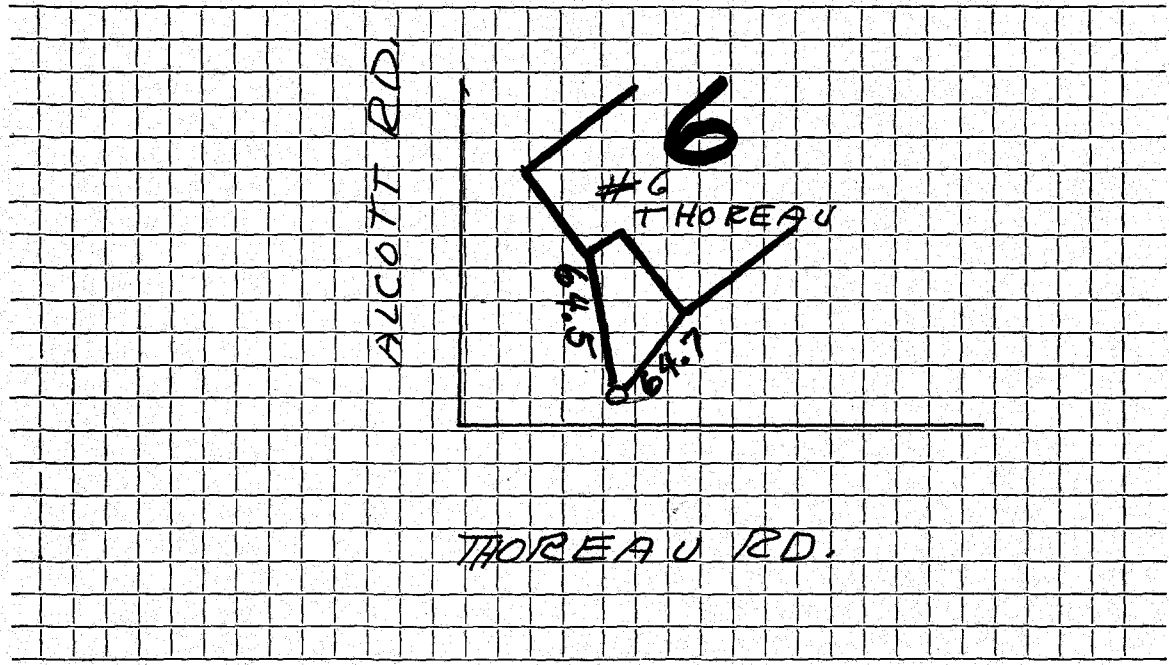

Connection made in THOREAU RD. Street. Work completed

Remarks:
.....
.....