

## WATER SERVICE RECORD

#6534

Name Richard Maganti

Service No. 94

Address 8 Thoreau Road

Location Lot #31

~~XXXXXX~~ ~~XXXXXX~~ ~~XXXXXX~~ - New Service


Comm 7-6-59

Date	Material	Amount	Total	Date	Amount	
5-22-59	Labor	2 36		5-18-59	Deposit	100 00
	10% O. H.	24	2 60	11-6-59	Returned	69 57
57'	3/4" Copper Tubing @.3666		20 90			30 13
1	3/4" C x 1/8 IWH Stop & Waste		5 88		NON CHARGE	
1	Hr. Trucking @.75		75	10-17-58	Labor	7.93
			30 13		28' 3/4" Copper tubing @.37	10.36
					1 3/4" C Corp Cock	4.64
					1 3/4" C Curb Cock	6.03
					1 Box & Rod	5.00
						33.96
				5-22-59	1 1/2 Straight Tailpiece	50
					1 1/2 Offset Tailpiece	50
						34 96

TOWN OF LEXINGTON — BOARD OF PUBLIC WORKS

**WATER DIVISION**

Sketch of Service Here

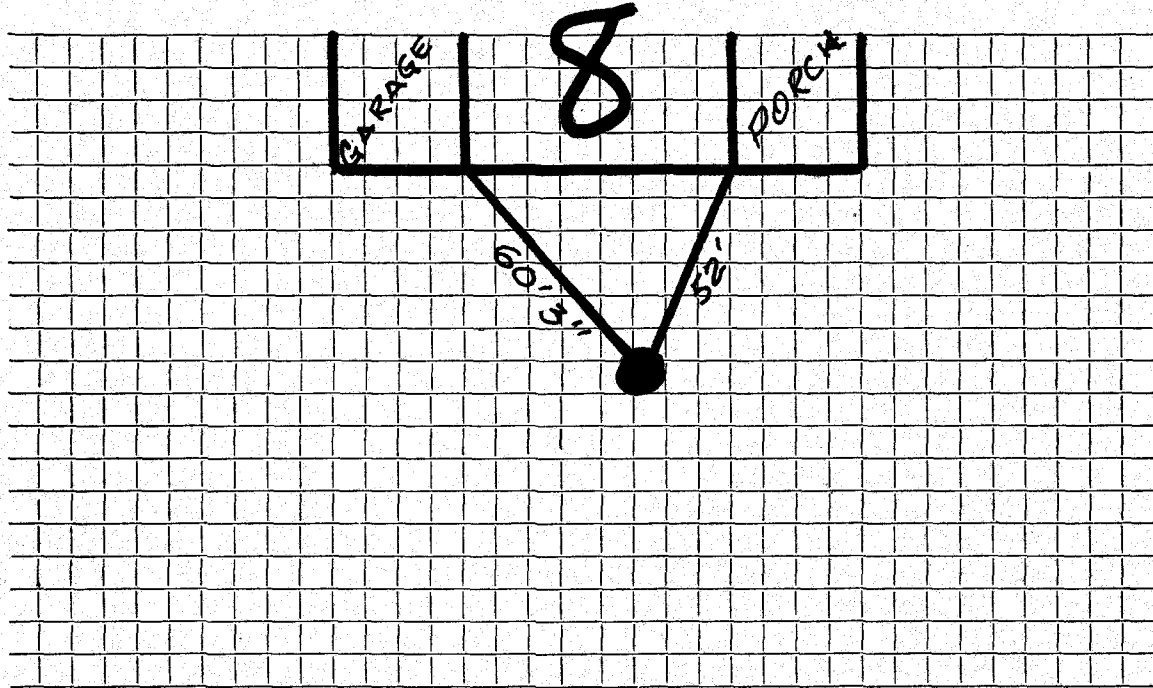

Connection made in THOREAU RD. Street. Work completed .....

Remarks: .....  
.....  
.....