




DATE 4/8/2020

TOWN OF LEXINGTON — BOARD OF PUBLIC WORKS

WATER DIVISION

Sketch of Service Here

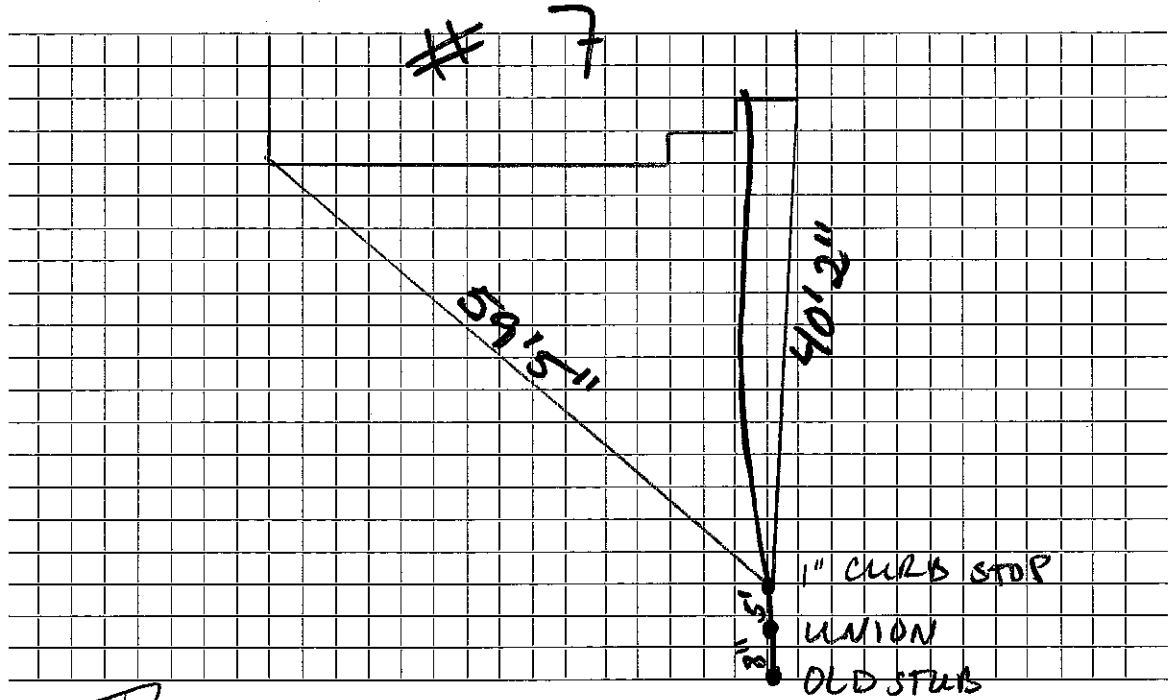

Connection made in Thoreau Street.

Work completed .....

Remarks: .....