

WATER SERVICE RECORD

Name R. J. Foley Realty Trust

Service No. 89

Address 1 Todd Road

Location Lot #9 Sta. 1+28

~~Repair~~ ~~Renewal~~ New Service W.O. #9103 DeFlice Bros. Permit #68

Comm 9-21-64


Date	Material	Amount	Total	Date	Amount
6-23-62	Labor	2.13		9-6-64	38.68
	10% O.H.	.21	2.34		
	13' 3/4" Copper tubing @.42		5.46		
	1 hr. Trucking @3.00		3.00		
	BILL WHEN CONNECTED		10.80		
			27.88		
			38.68		
8-24-64	76' 3/4" Copper tubing			6-23-62	2.13
					9.66
					4.91
					6.28
					4.90
					27.88

Deposit

~~CHARGE~~ CHARGE

TOWN OF LEXINGTON — BOARD OF PUBLIC WORKS
WATER DIVISION

Sketch of Service Here

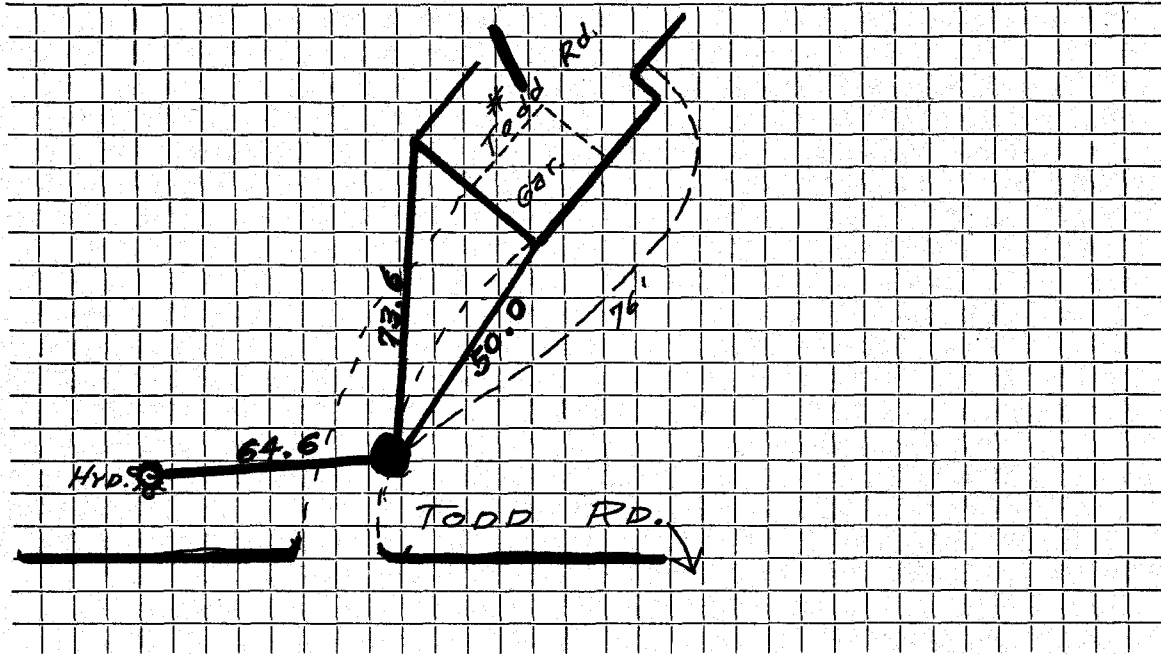

Connection made in Street. Work completed

Remarks:

.....

.....