

WATER SERVICE RECORD

Name Moore Realty Trust

Service No. 131

Address 10 Todd Road

Location

Remarks ~~Remarks~~ - New Service


MAR 23 1964

Date	Material	Amount	Total	Date	Amount
11-15-63	Labor	3 43		11-5-63	50 00
	10% O.H.	34	3 77	3-23-64	12 45
60'	3/4" Copper tubing @.42		25 20	<i>Deposit</i>	
1	3/4" CX $\frac{1}{2}$ " I.W.H. Stop & Waste		6 17	<i>* Refund</i>	37 55
1	3/4" C3 Part Union		2 41		
			37 55	NON CHARGE	
				11-15-63	
				1	$\frac{1}{2}$ Straight Tailpiece 50
				1	$\frac{1}{2}$ Offset Tailpiece 50
					1 00
				<i>* Apply to W.H.C.H. # 763</i>	

TOWN OF LEXINGTON — BOARD OF PUBLIC WORKS

WATER DIVISION

Sketch of Service Here

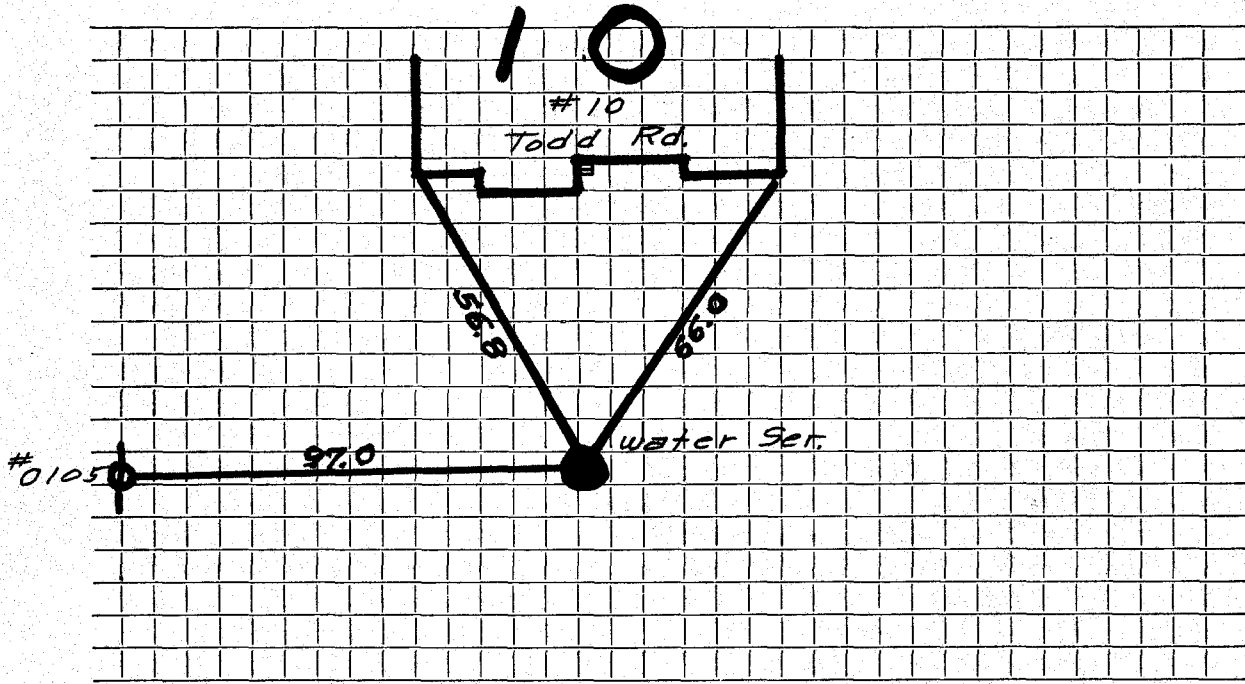

Connection made in Street. Work completed

Remarks:
.....
.....